


FILE 4-00-014-A

160
94.15
117.55

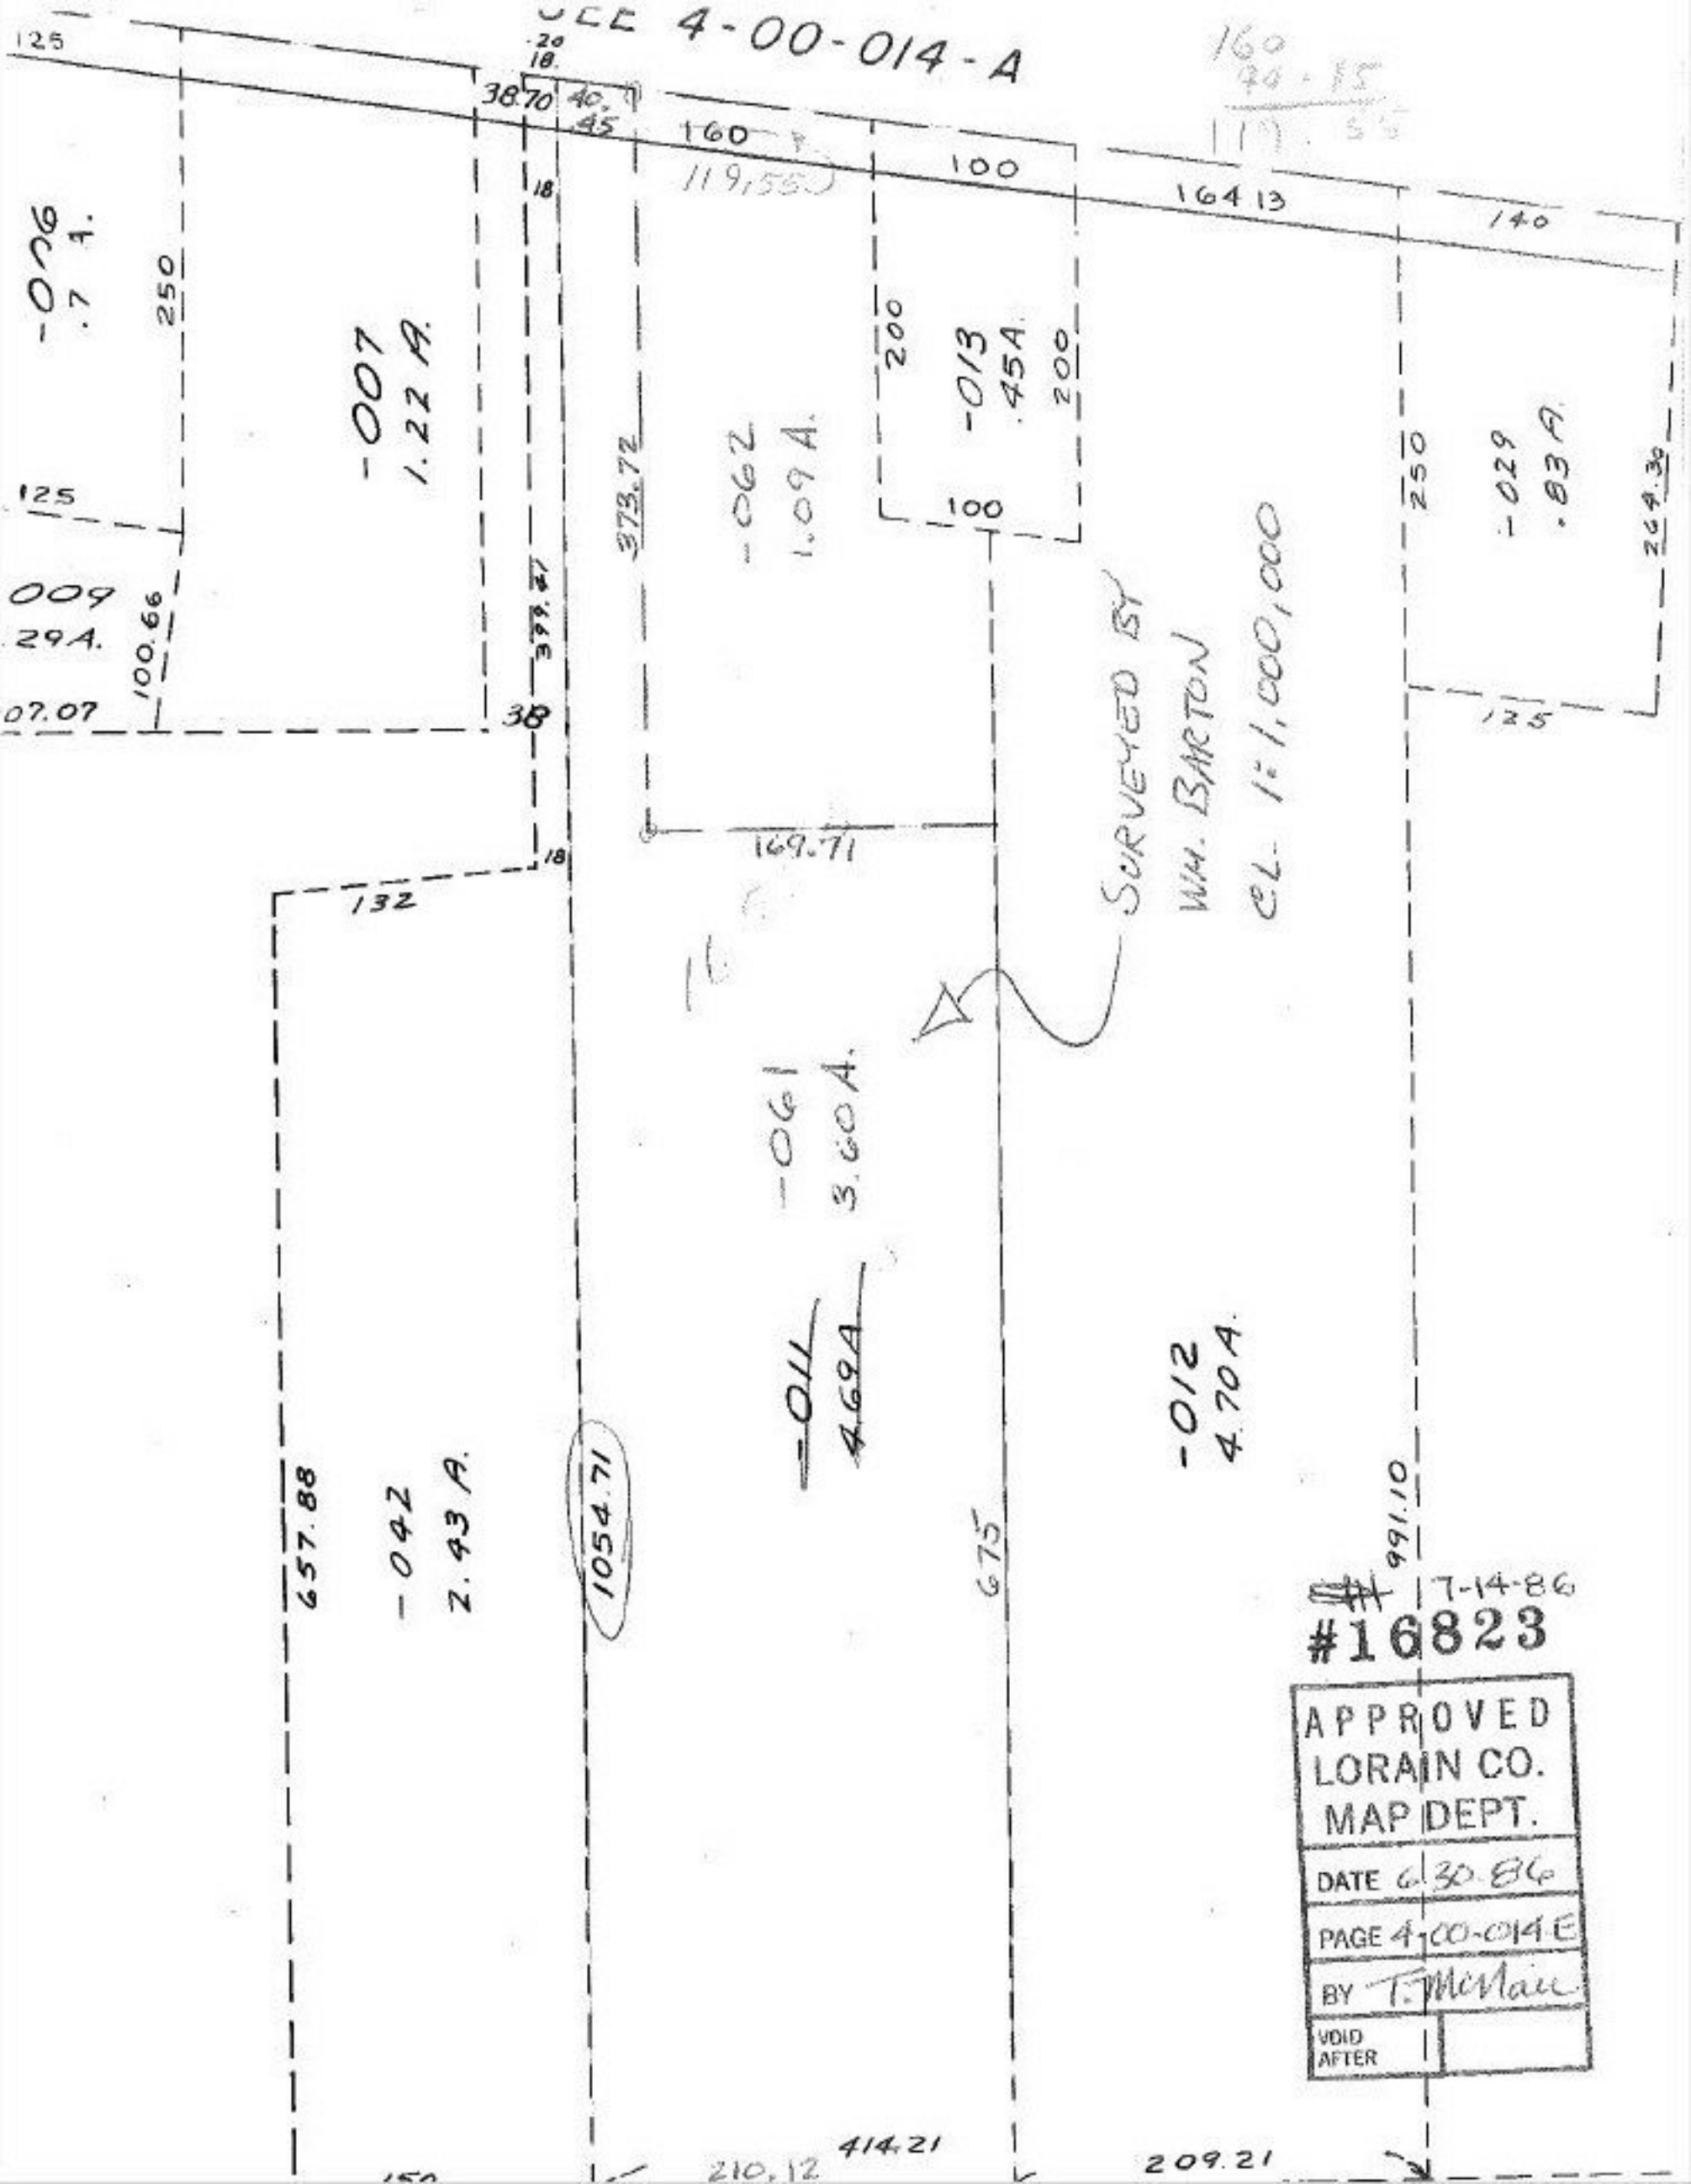

-006
.7 A.

-007
1.22 A.

009
29 A.
07.07

-062
1.09 A.

-013
.45 A.

SURVEYED BY
WM. BARTON
E.L. 1:1,000,000

-029
.83 A.

-042
2.43 A.

-061
3.60 A.

-011
4.69 A.

-012
4.70 A.

1054.71

#16823

APPROVED	
LORAIN CO.	
MAP DEPT.	
DATE	7-14-86
PAGE	4-00-014 E
BY	T. McNamee
VOID AFTER	

210.12 414.21

209.21