


15

-017
16.00A.

COLUMBIA - WEST RIVER

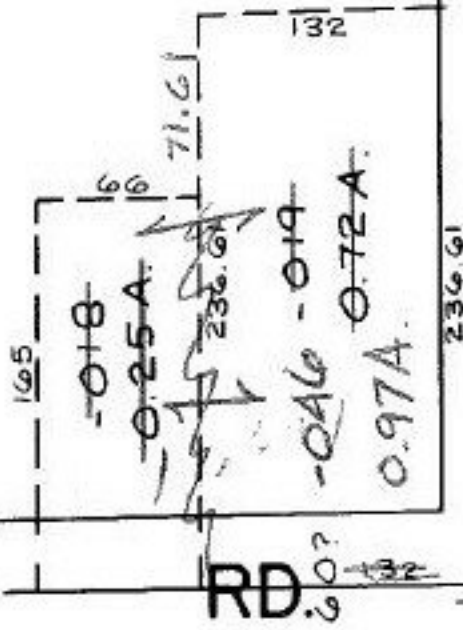

7-22-86

976.17



RD. 30?

60

#16827

COMBINATION	APPROVED LORAIN CO. MAP DEPT.	
	DATE 7.1.86	
	PAGE 12-00-056.B	
	BY T.M. Main	
	VOID AFTER	

5-B