

-006  
60.00 A.

SURVEYED BY WM. FOX  
CL. 1: INF.

-012  
22.50 A.

385  
-011  
300A.  
547

-015  
35.31 A.

-014  
48.26 A.

-016  
12.95 A.

32

-013  
30.64 A.

-005  
3.09 A.

-009  
29.15 A. SA 12-18-86  
#16831


APPROVED  
LORAIN CO.  
MAP DEPT.  
DATE 7.3.86  
PAGE 16-D  
BY T. McVain  
VOID AFTER

-008  
2.98 A.

-017

-020  
0.17A.

DUP.  
need

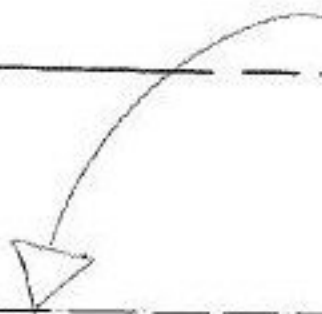

RRS

RRS

(SUBTRACTED)

Mont.

437.50  
410.5  
195.09  
235.01  
235.01  
801.74  
470.02  
800.04  
1497.66  
597.30  
887.30

26  
80

884.62

383.06  
1133.70  
1315.79  
765

710.1

509

1825.47

1124.4

-004 FRONTAGE OF -016 IS 498.07 WHEN 30.95 A. SUBTRACTED FROM SURVISTORS DIMENSION FROM S. LINE OF 32 1124.40 & 502.79 WHEN SUBTRACTED FROM -014 FRONTAGE AS SHOWN.

498.07

1875.47

492.4

120

505

260

246

273

273

250

740

280

382.5

-008

1.23

430.5

-003

1.38 A

478

-004

1.53 A

52

RRS

250

184

217.8

-006

0.50A

100

217.8

398

352

-018

250

250

502.61

-017

5.15

273

273

5

5

