

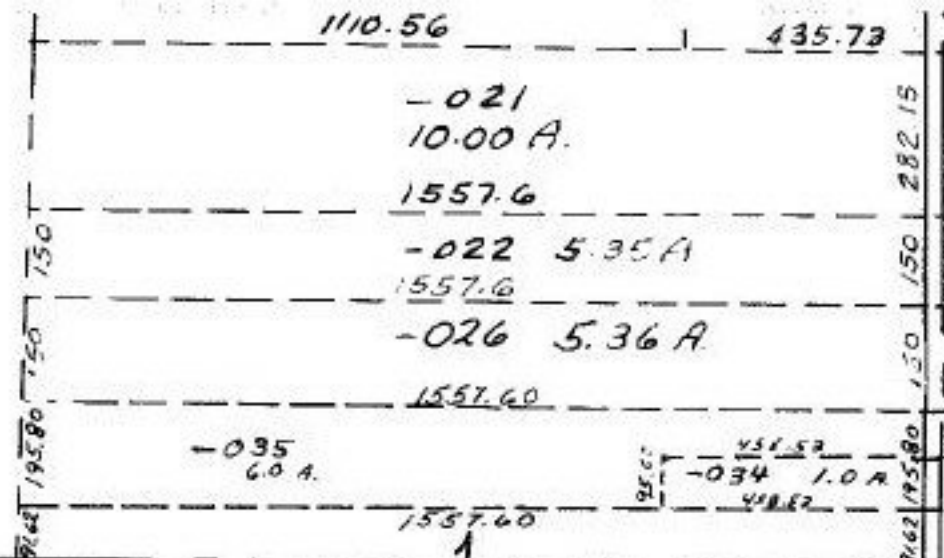
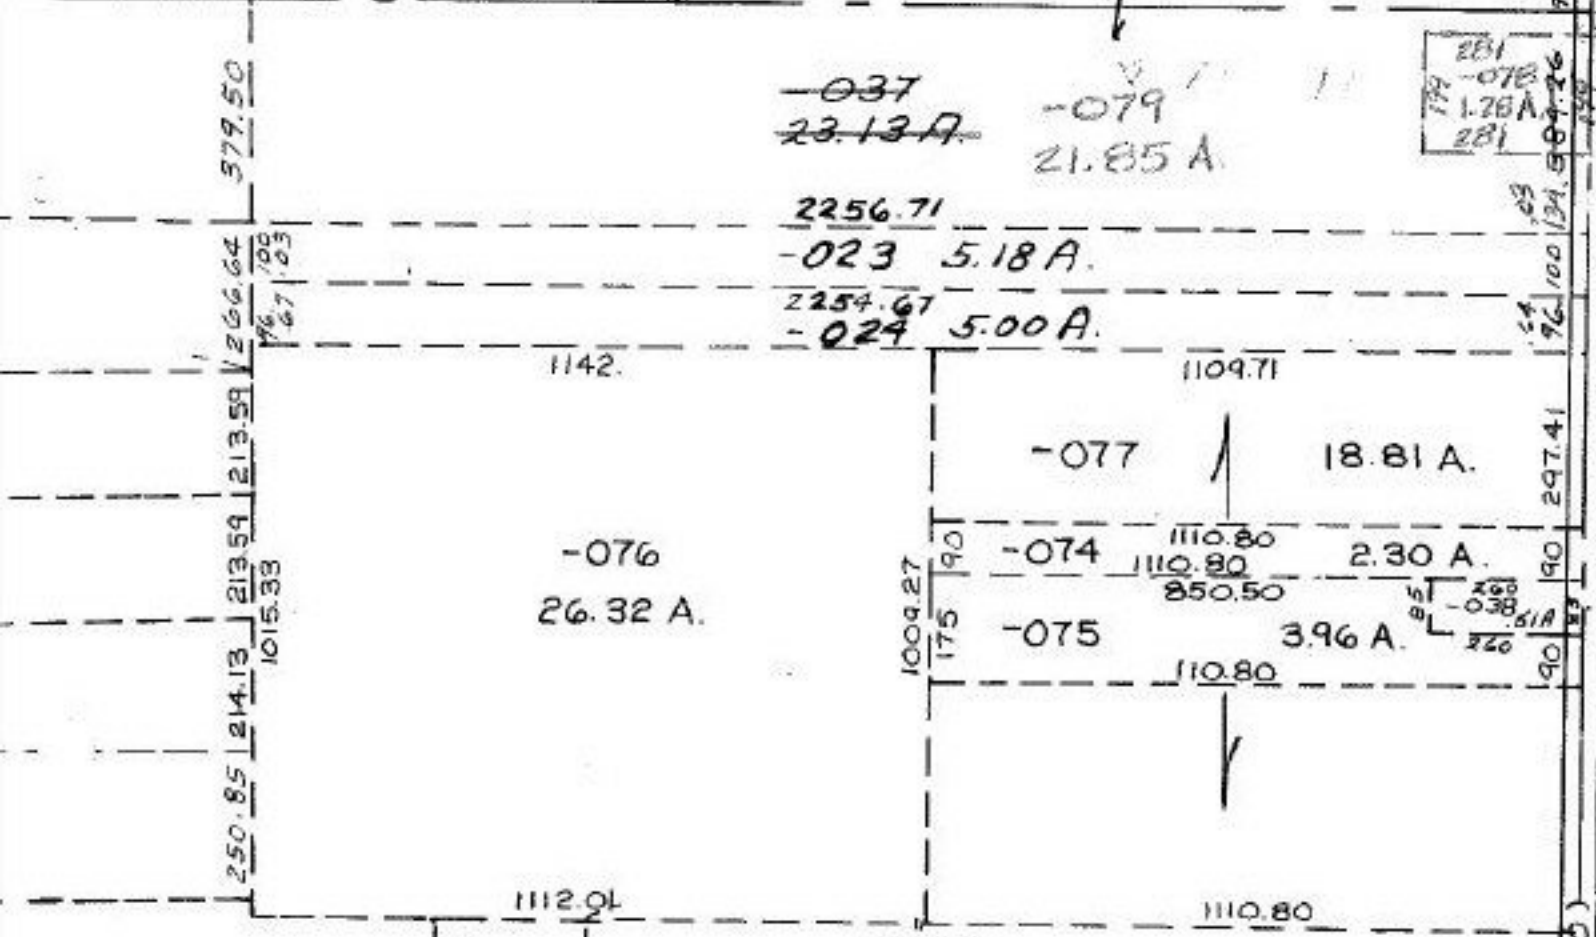


-009
6.95A.

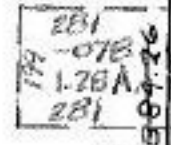

SEE SURVEY
LAWRENCE SIMON CAHL
EL. 12 INF.

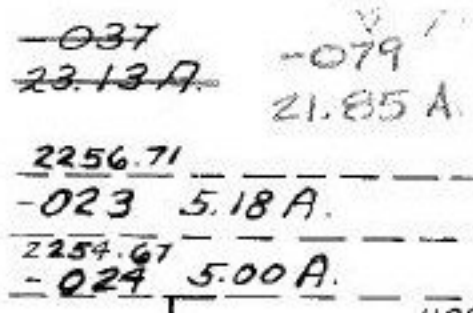

29

7-17-86

00-029-C

SEE 7-00-029-D

SEE 7-C
16841

APPROVED LORAIN CO. MAP DEPT.	
DATE 7-8-86	
PAGE 7-B	
BY T. McMan	
VOID AFTER	