


SEE 4-00-011-D



SHH 7-17-86  
 # 16849  
 APPROVED  
 LORAIN CO.  
 MAP DEPT.  
 DATE 7-15-86  
 PAGE 4-00-014-A  
 BY *[Signature]*  
 VOID AFTER 1/6849

~~103~~  
~~040~~  
~~043~~  
 23.66A.  
 102

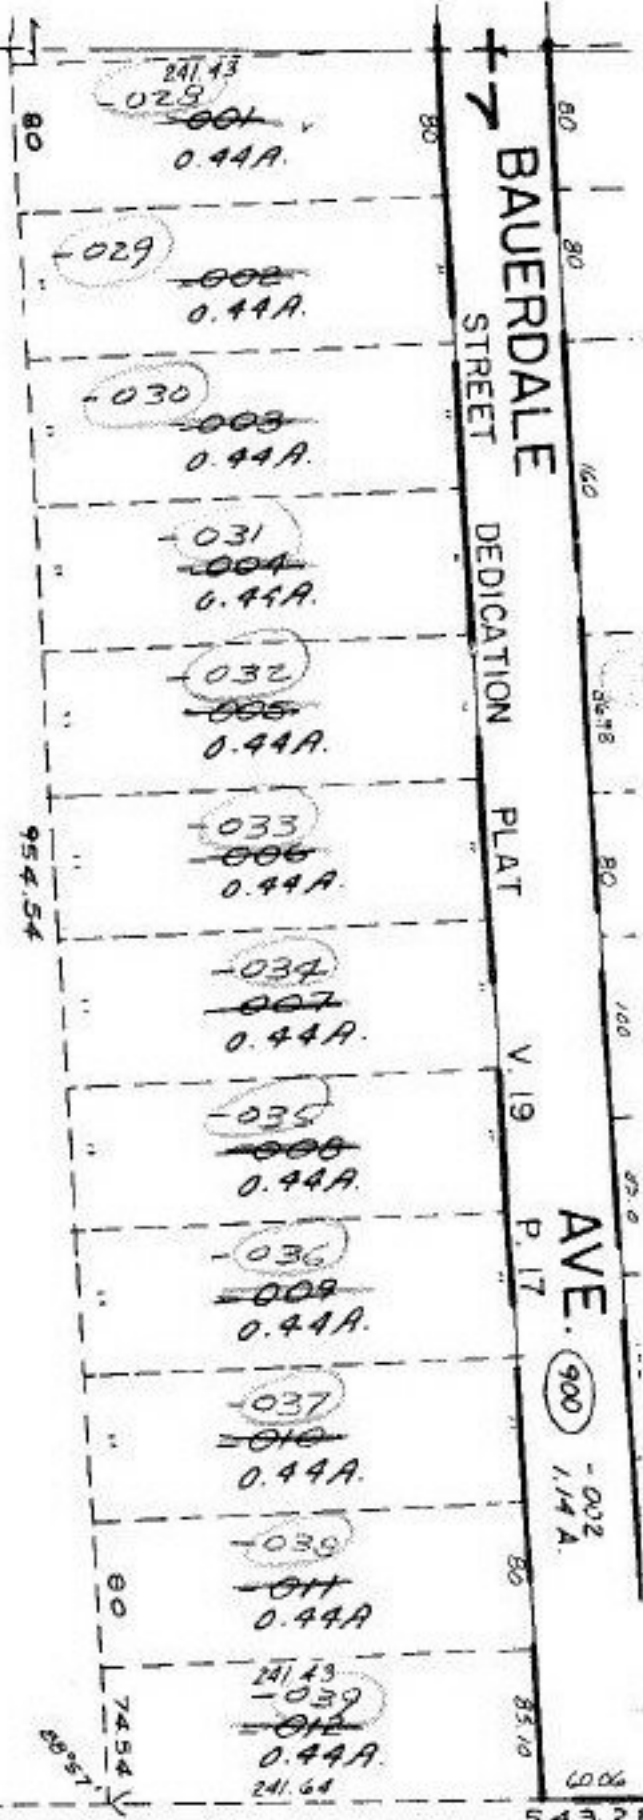

SEE 4-00-014-B