

3.08

27
30

FRENCH - CREEK

409.25

300

RD.


60

-012

1.39 A.

836.39

161.09

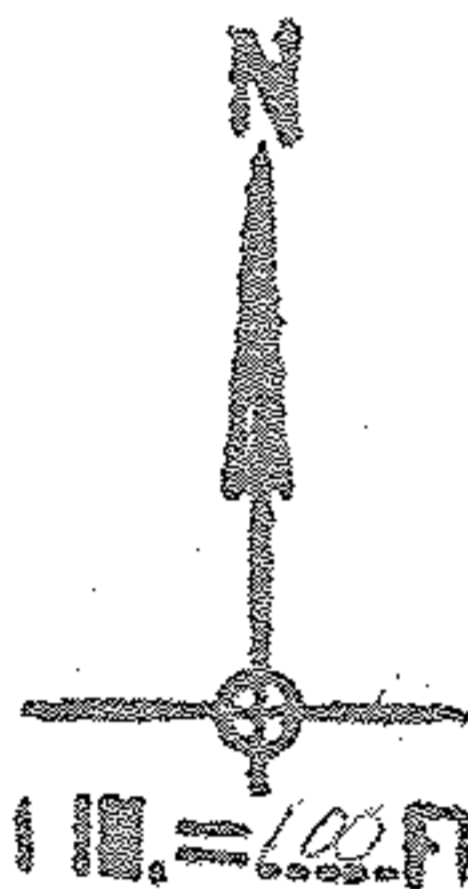


1685
1586

-016
Pt. ~~014~~
Pt. ~~42.29 A.~~
38.34 A.

APPROVED
LORAIN CO.
MAP DEPT.
DATE 4-18-68
3-00-005-B
BY
Hollert

7-~~14~~-86
S.S

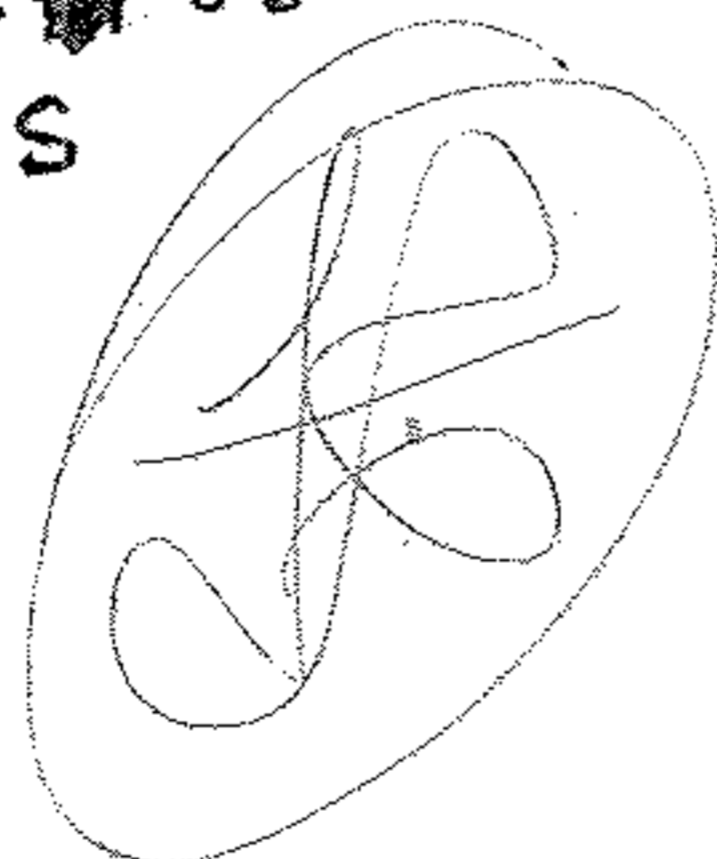

SEE 4-00-002-A

PG 3-00-005-B