


CREEK

RD.

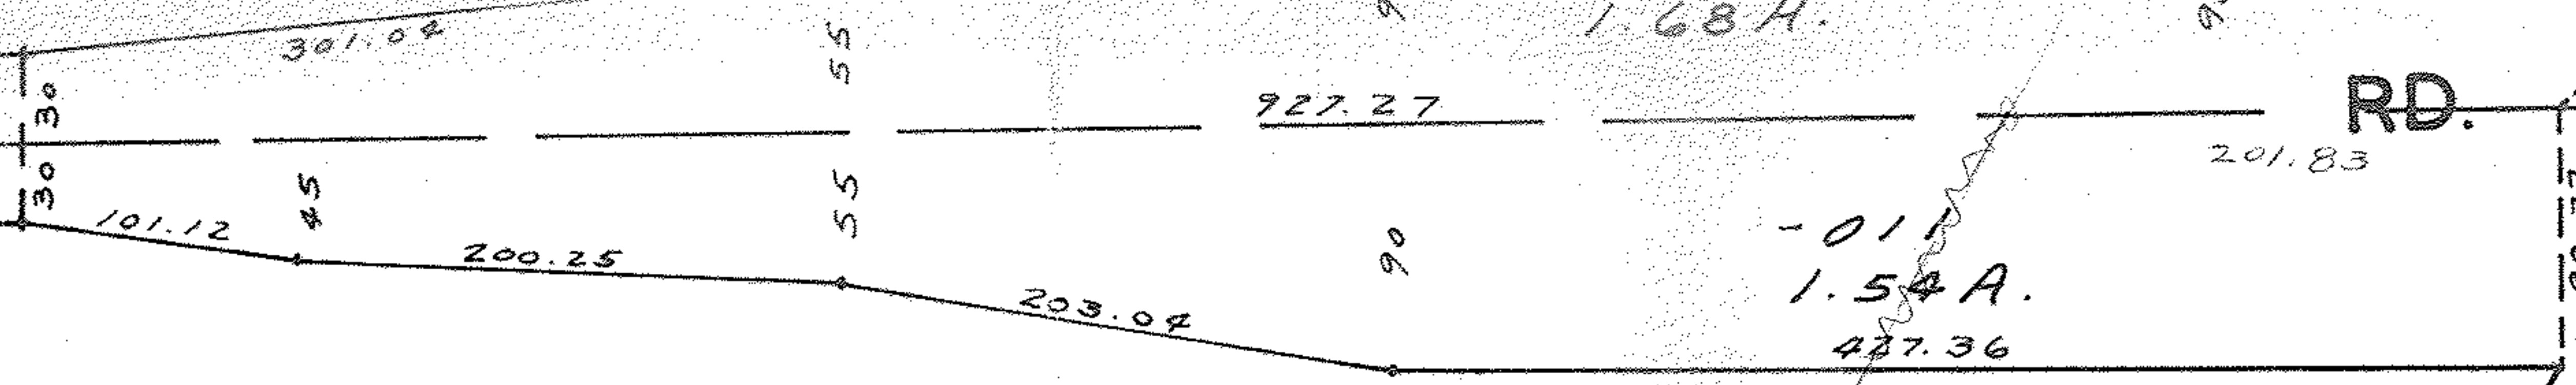

Pt. -016
~~Pt. -016~~
 Pt. ~~43-29 A.~~
 38.34 A.

-015
 4,95 A.

DOME 5-4-68
 2 W HALL

INTERSTATE



1685
 1586

APPROVED
LORAIN CO.
MAP DEPT.
DATE 4-18-68
3-00-005-A
BY Hollbert

721-86
 S.S

224.70
 224.69

594.01

244.11

SEE 3-00-004-A