
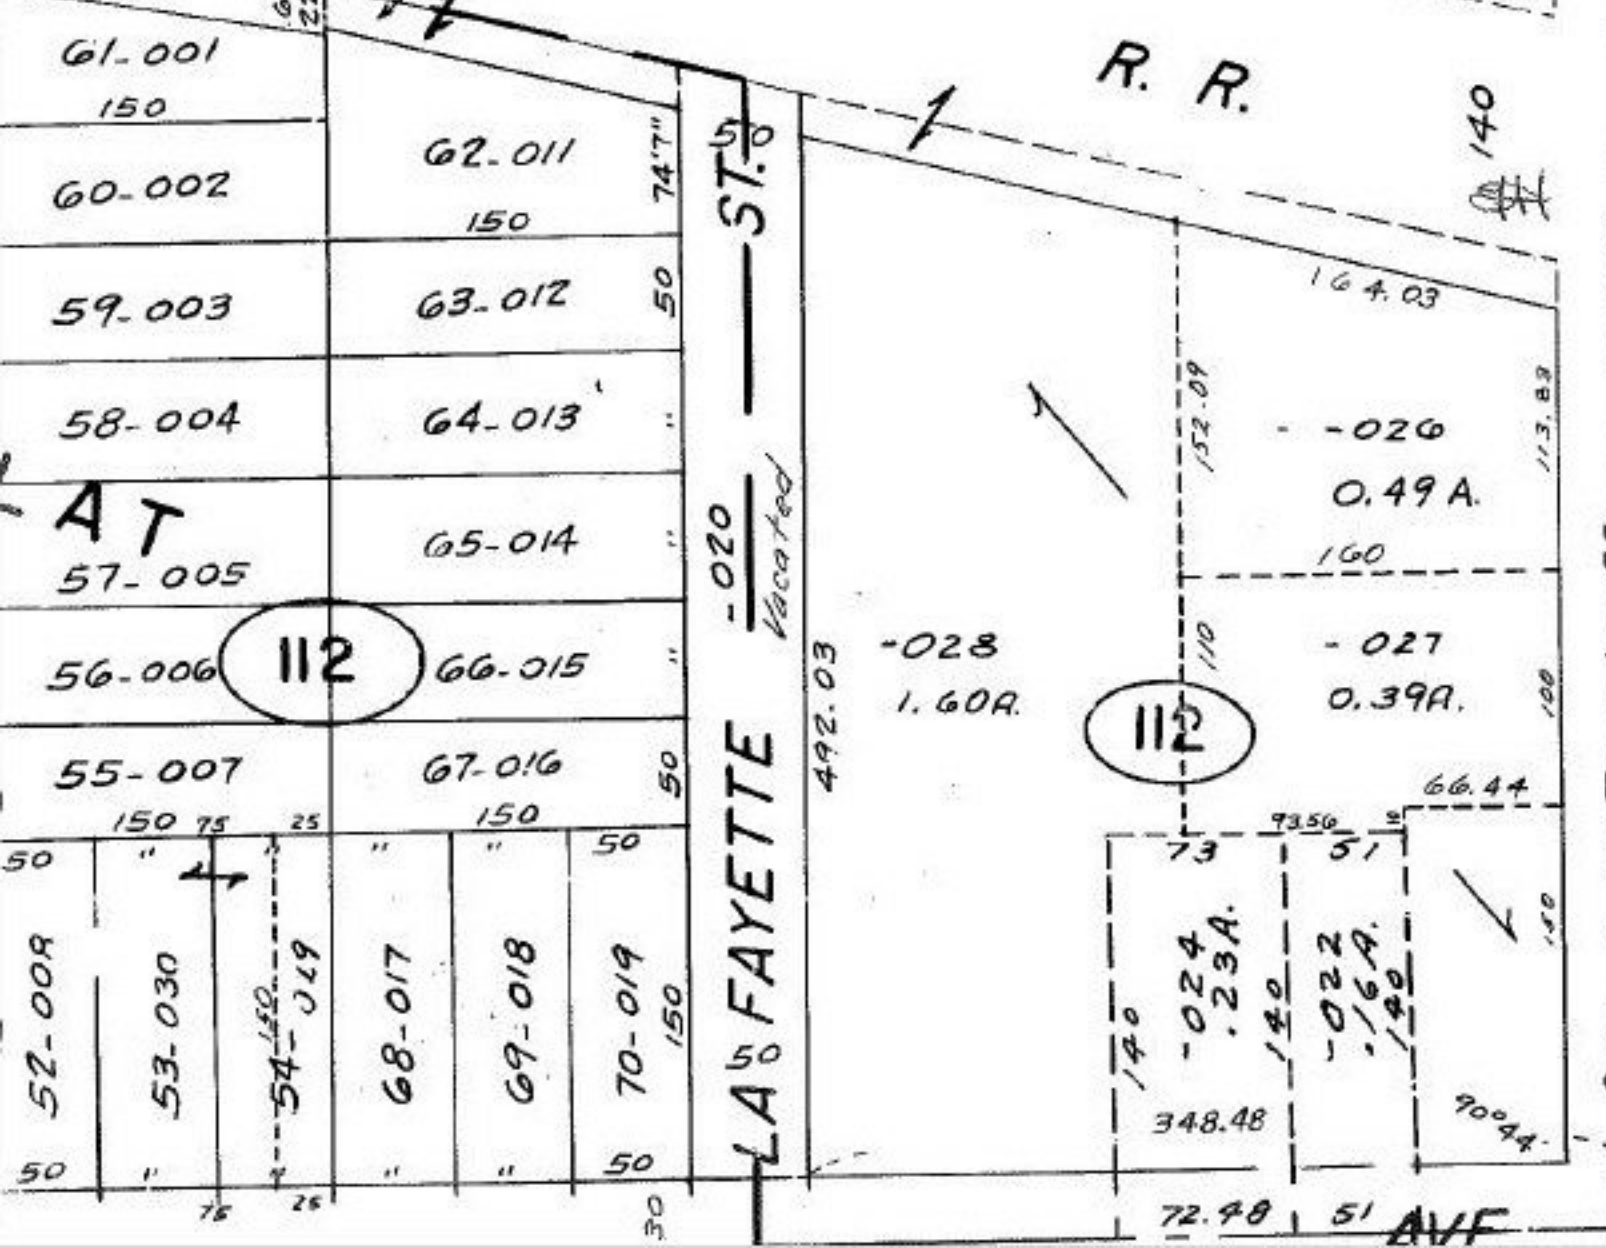


ACRES

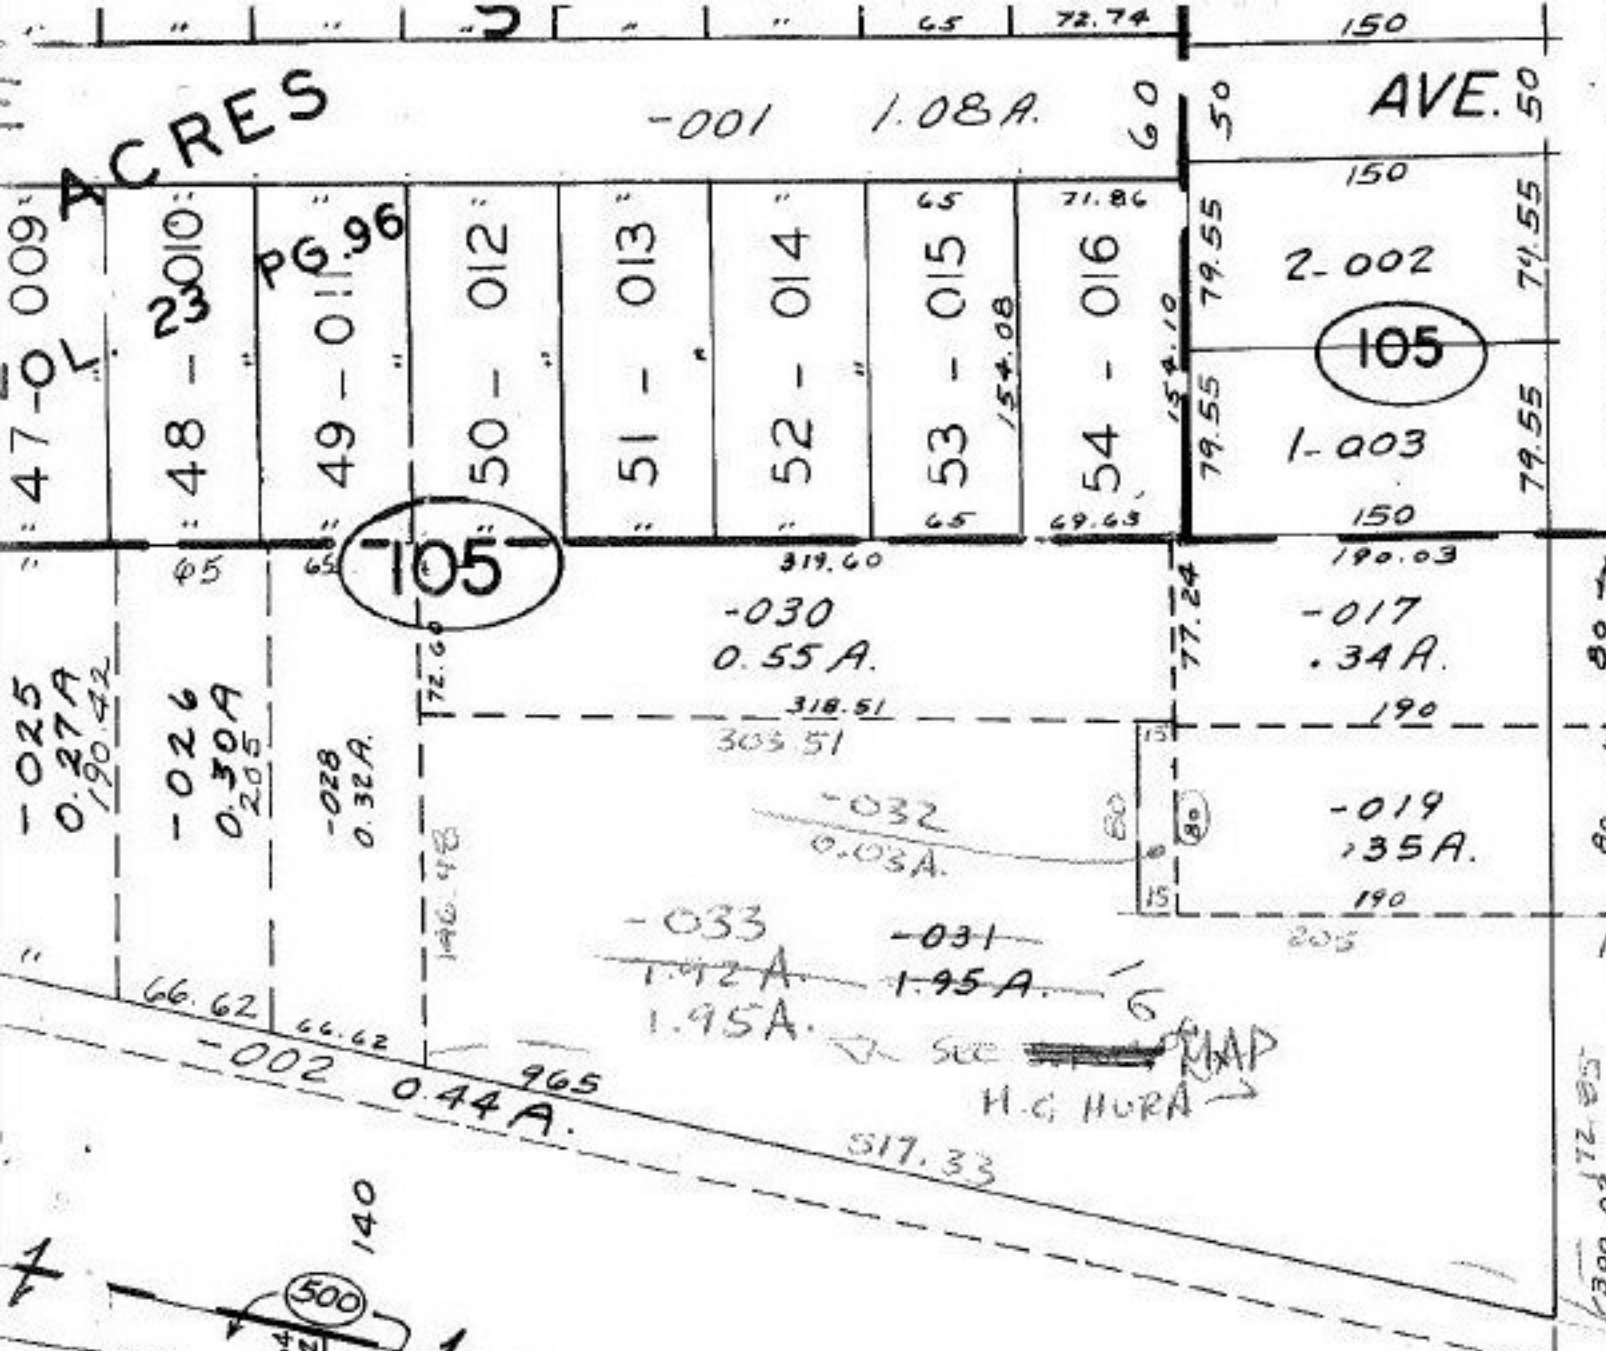

7-17-86
#16857

APPROVED
LORAIN CO.
MAP DEPT.

DATE 7-11-86

PAGE 5-00-003-B

BY T. McHain

VOID
AFTER

ON. LAKE