


- 001  
2.86F.

# COMBINATION

677.32 S. 86° 32' E.

N. 89° 52' E. 820

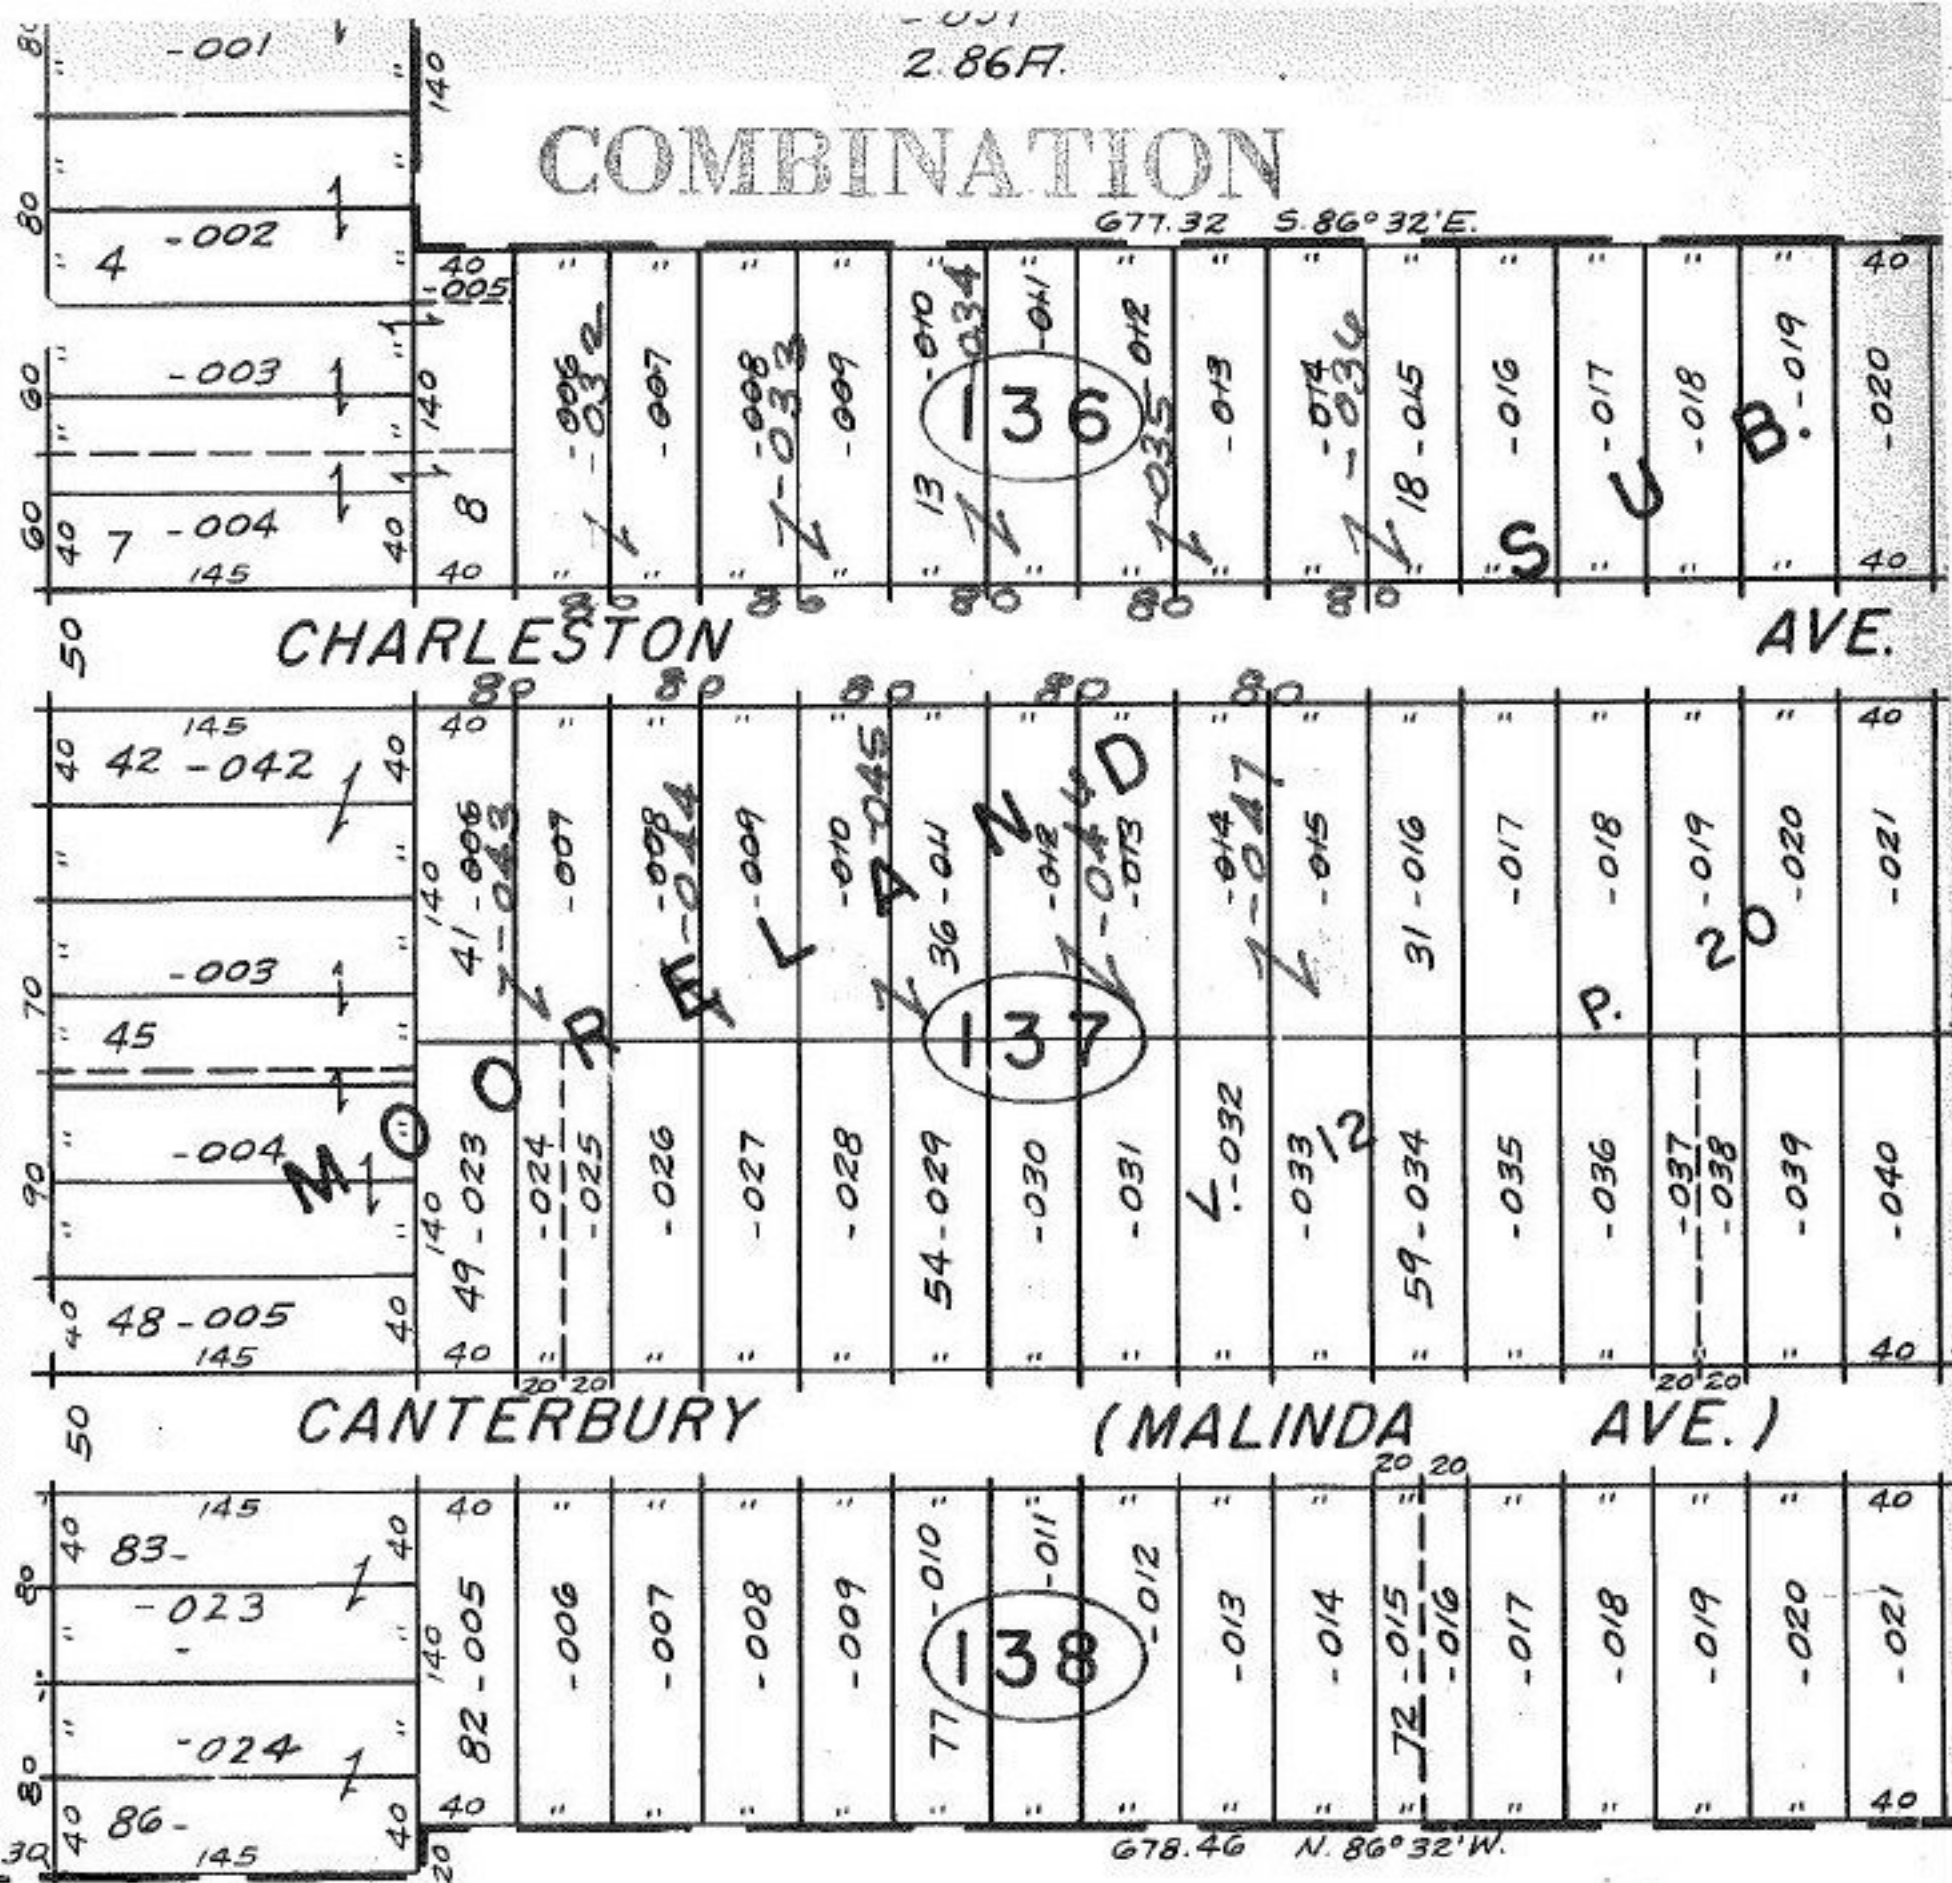

CHARLESTON

AVE.

CANTERBURY

(MALINDA

AVE.)

04-00-007-136-  
137-

- 001  
6.19F.

9-25-86  
#16874

APPROVED LORAIN CO. MAP DEPT.	
DATE 7-21-86	
PAGE 4-00-007-E	
BY Francis	
VOID AFTER	16874