


COMBINATION

#16879

SEE 6-1

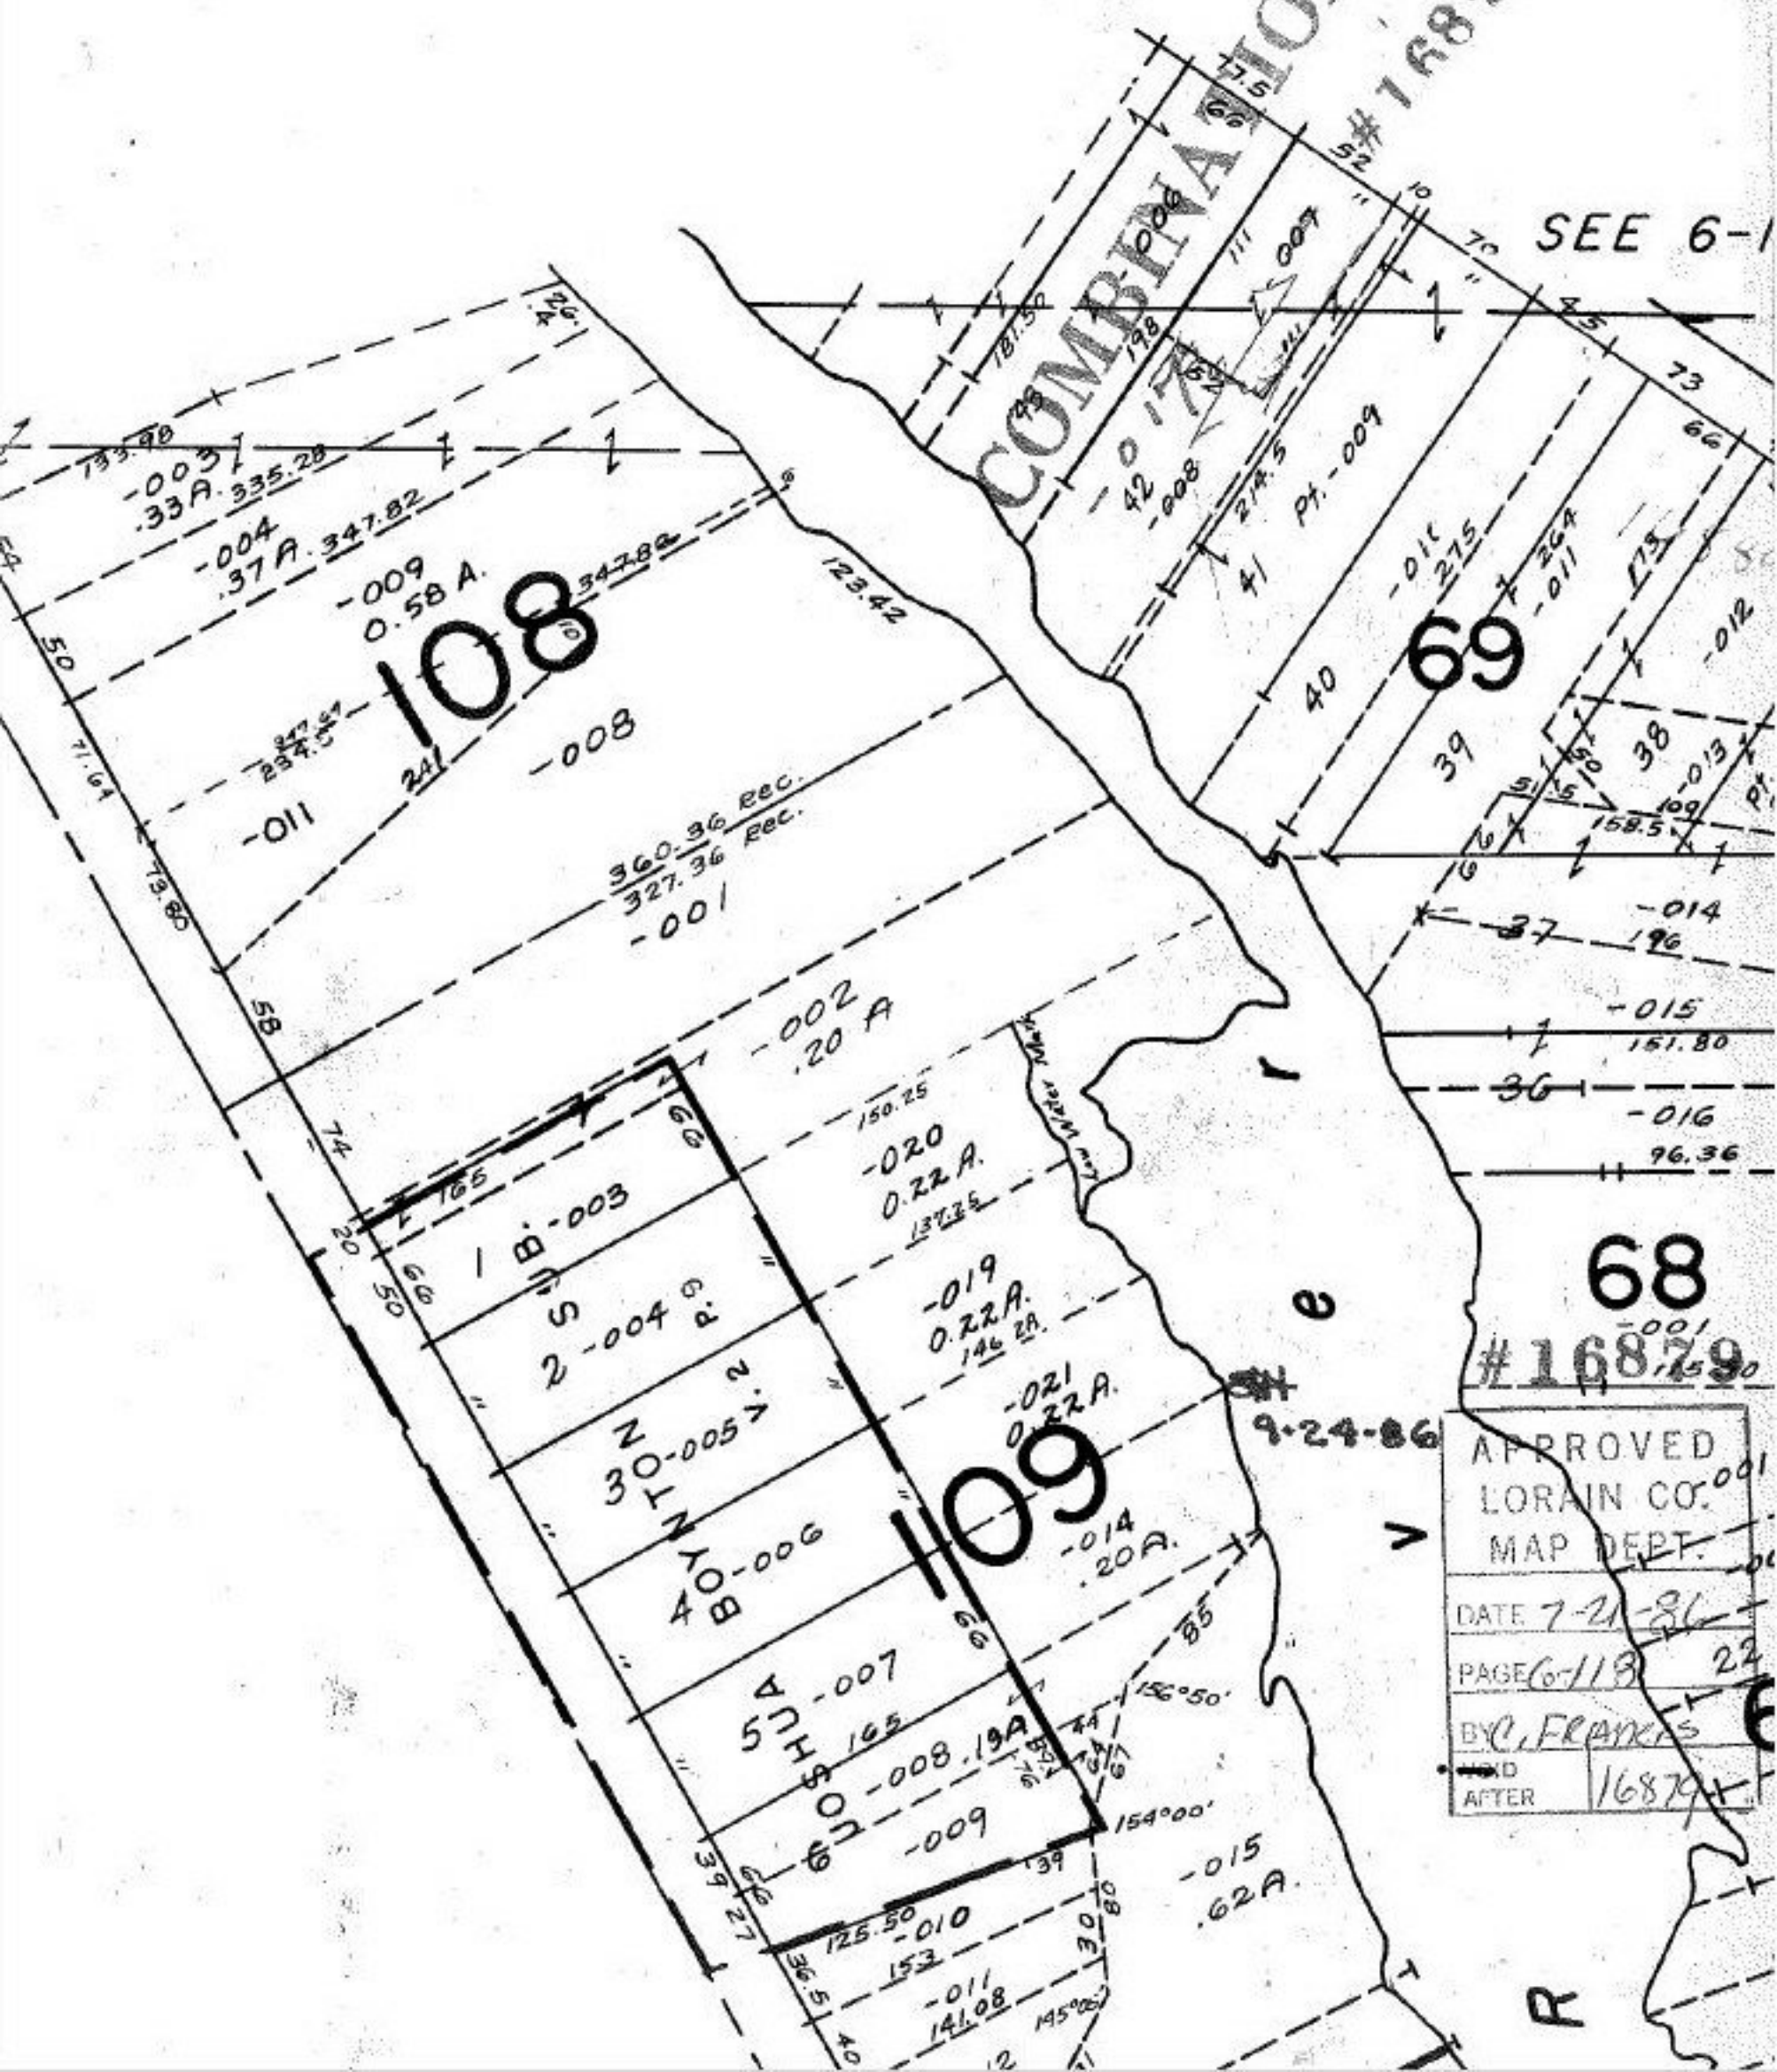

108

69

68

109

#16879

APPROVED
LORAIN CO. MAP DEPT.
DATE 7-21-86
PAGE 6-113
BY C. FRANKS
D AFTER 16879

9-24-86

R