


SEE 5-D

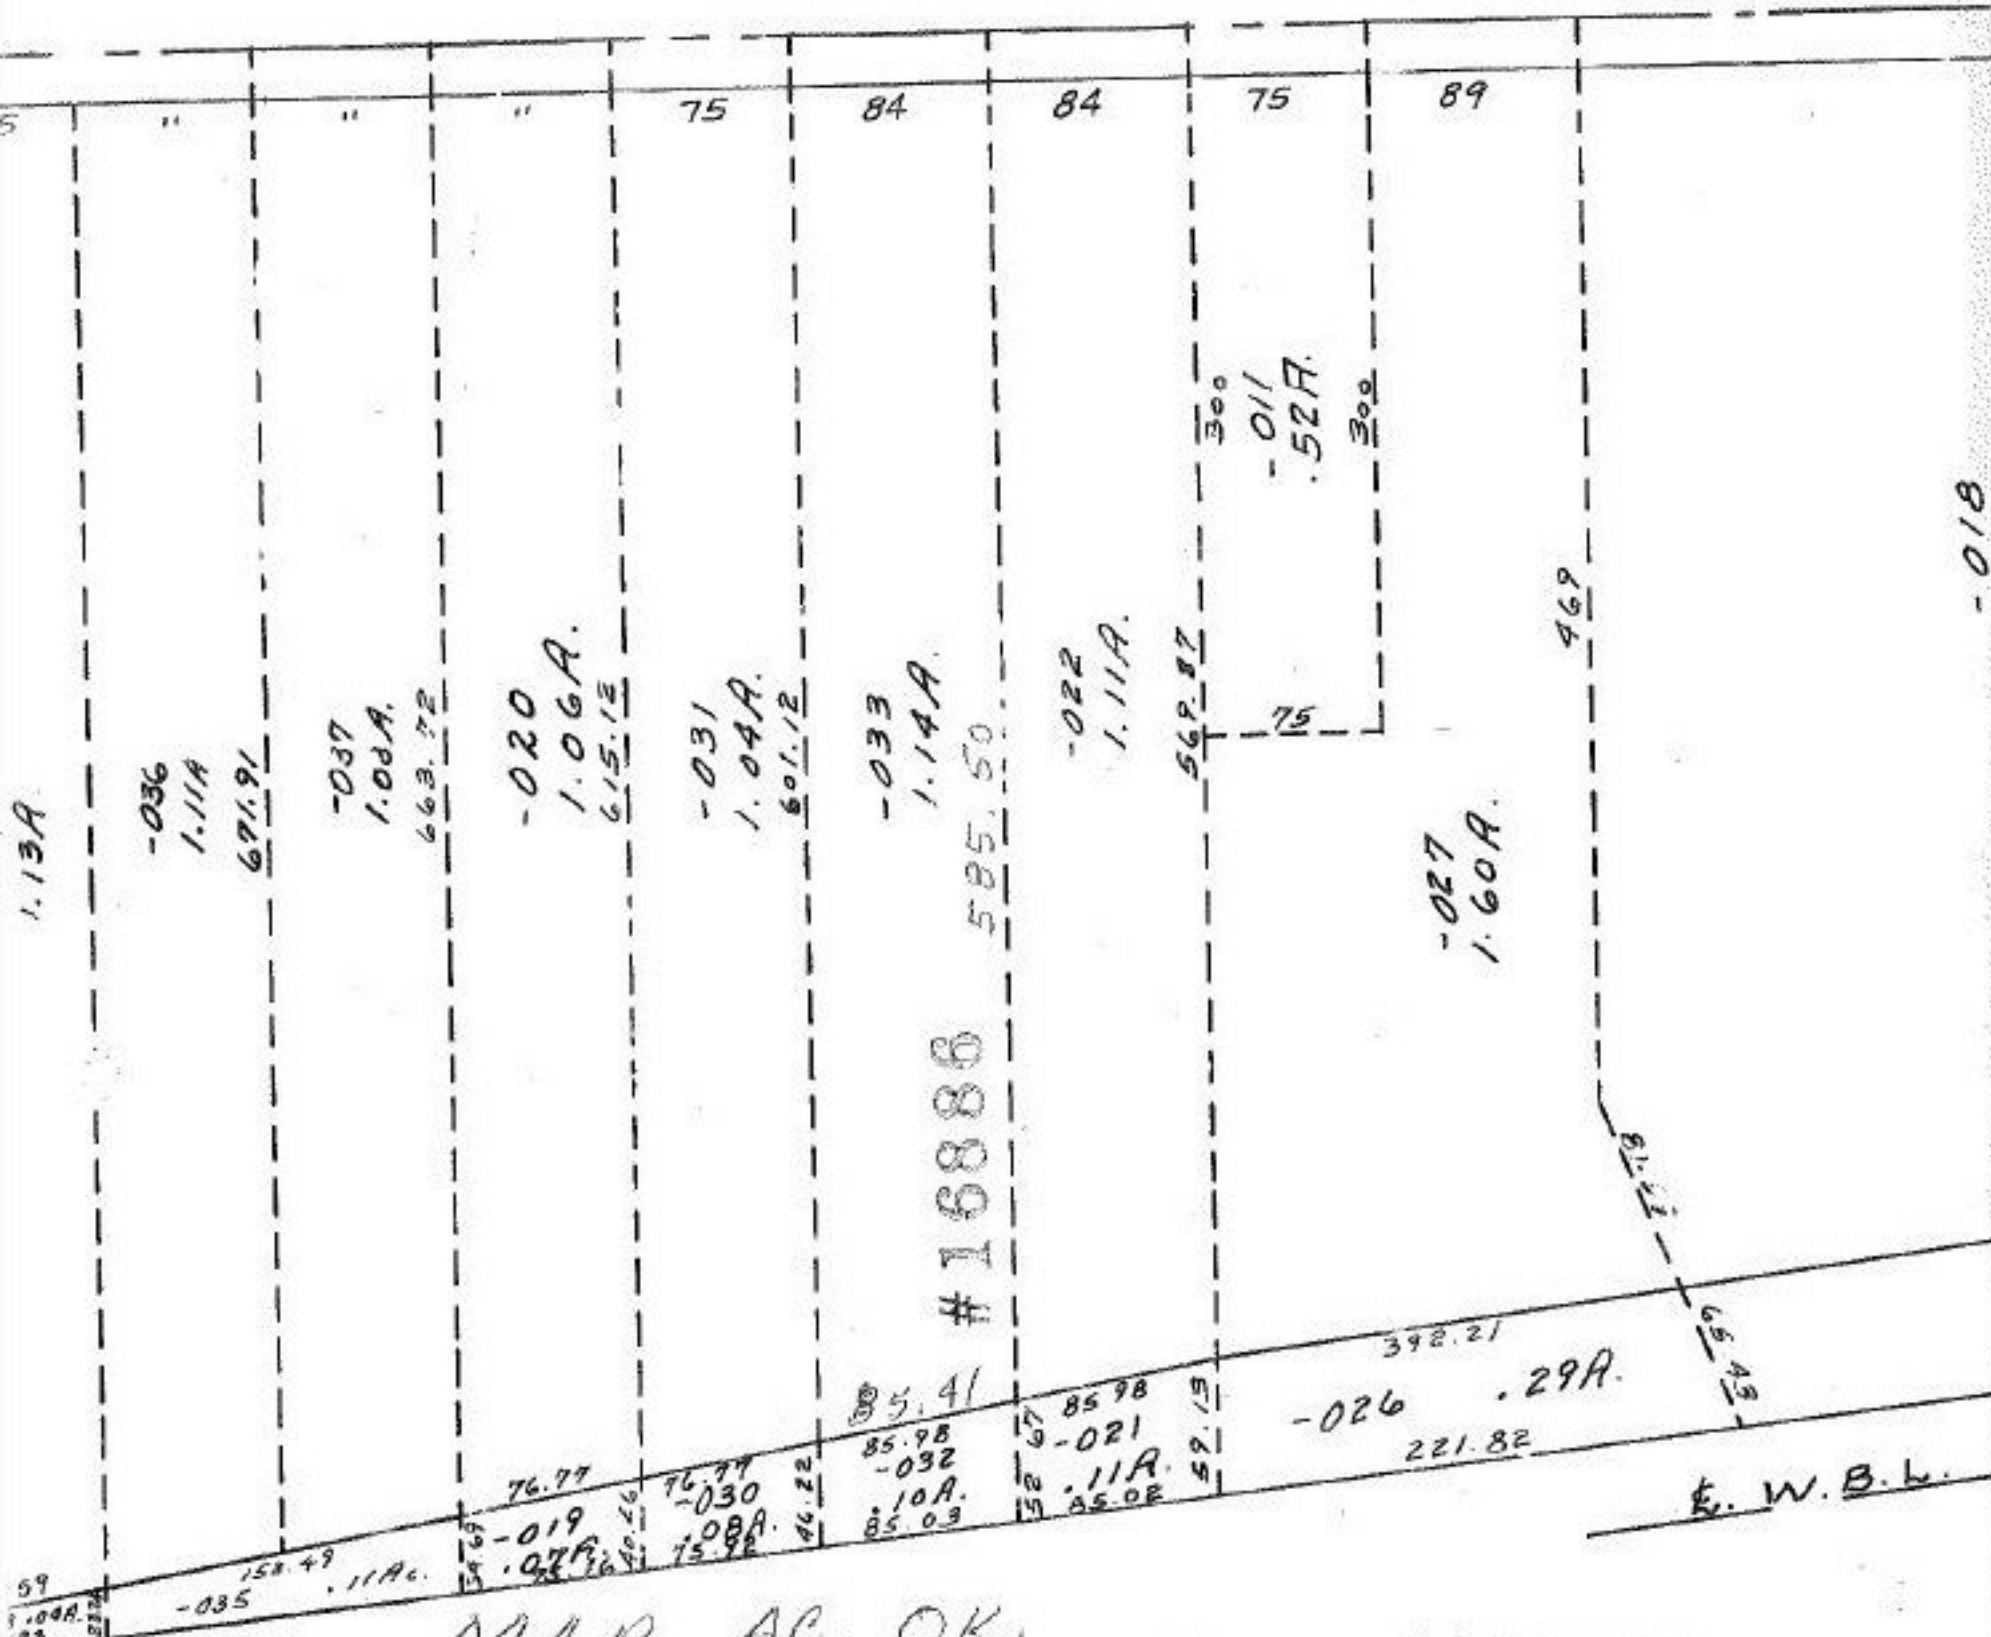

MAP AC. OK.

(DISTANCE INFO ADD ONLY)

-014

9.60A.

9-29-86
16886

TURNP

| | |
|-------------------------------------|-------|
| APPROVED LORAIN CO. MAP DEPT. | |
| DATE 7-29-86 | |
| PAGE 6.255-00-085 | |
| BY C. FRANCIS | |
| VOID AFTER | 16886 |

P. STA. 520

-018