


SEE

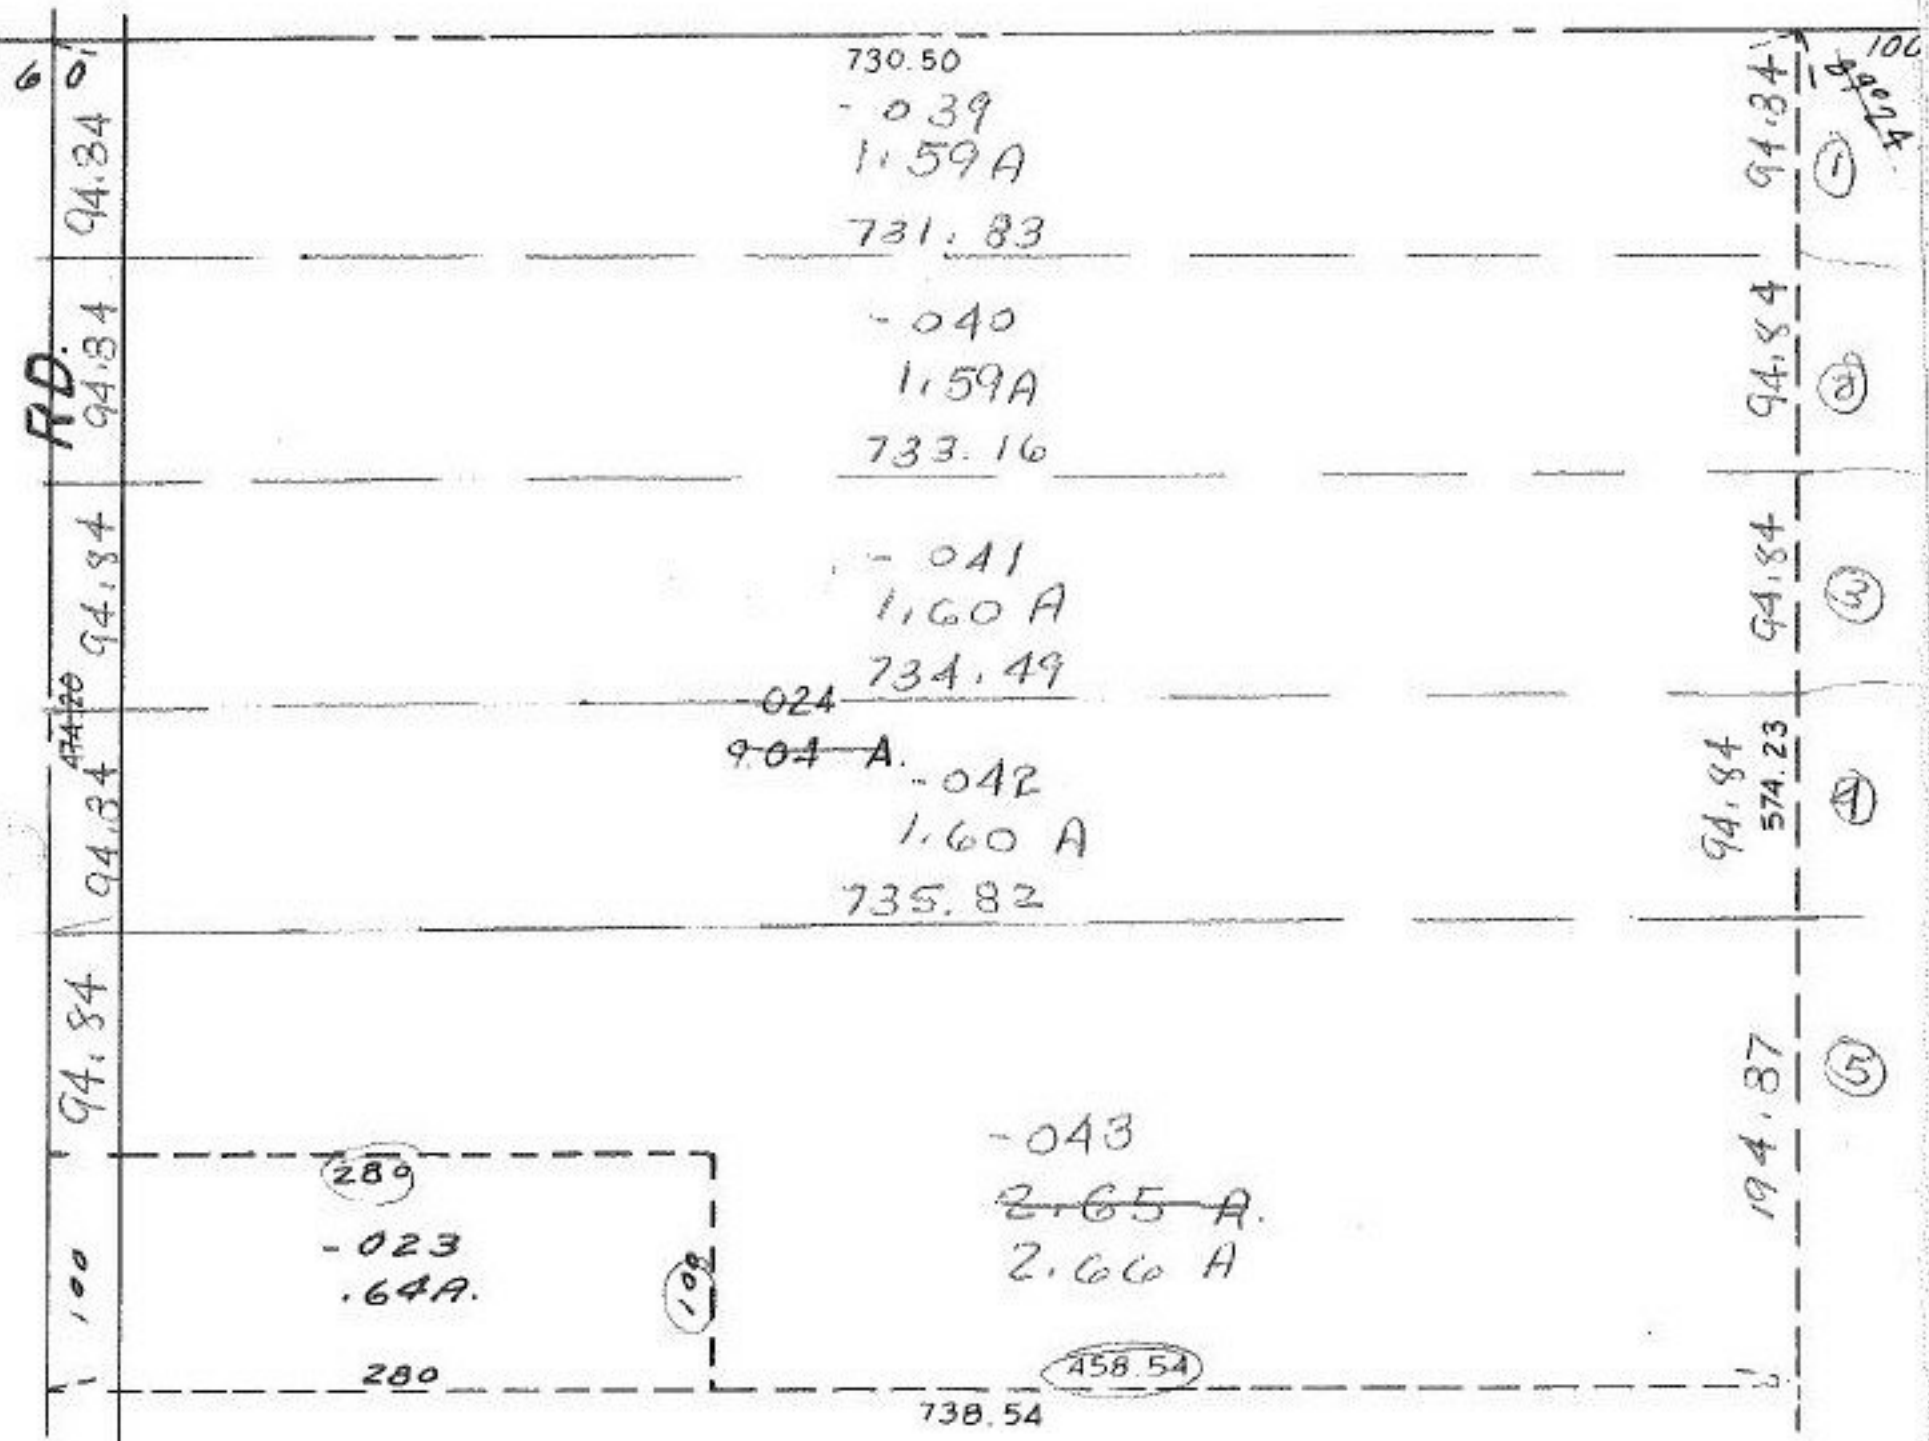

Prior Dec A Ref. 1349/170  
 Surveyed By W.B. Barton  
 Reg. Surveyor

- ① C = 1:333333.
- ② C = 1:333333
- ③ C = 1:333333
- ④ C = 1:333333
- ⑤ C = 1:76923.

-002  
 7.51 A.

SA 10-7-86  
 # 16889

APPROVED  
 LURAIN CO.  
 MAP DEPT.  
 DATE 7-24-86  
 PAGE 3-00-002  
 BY C. Francis  
 VOID AFTER 16889

441.54