


SEE SURVEY
A. KOEPP
C.L. 1:58823

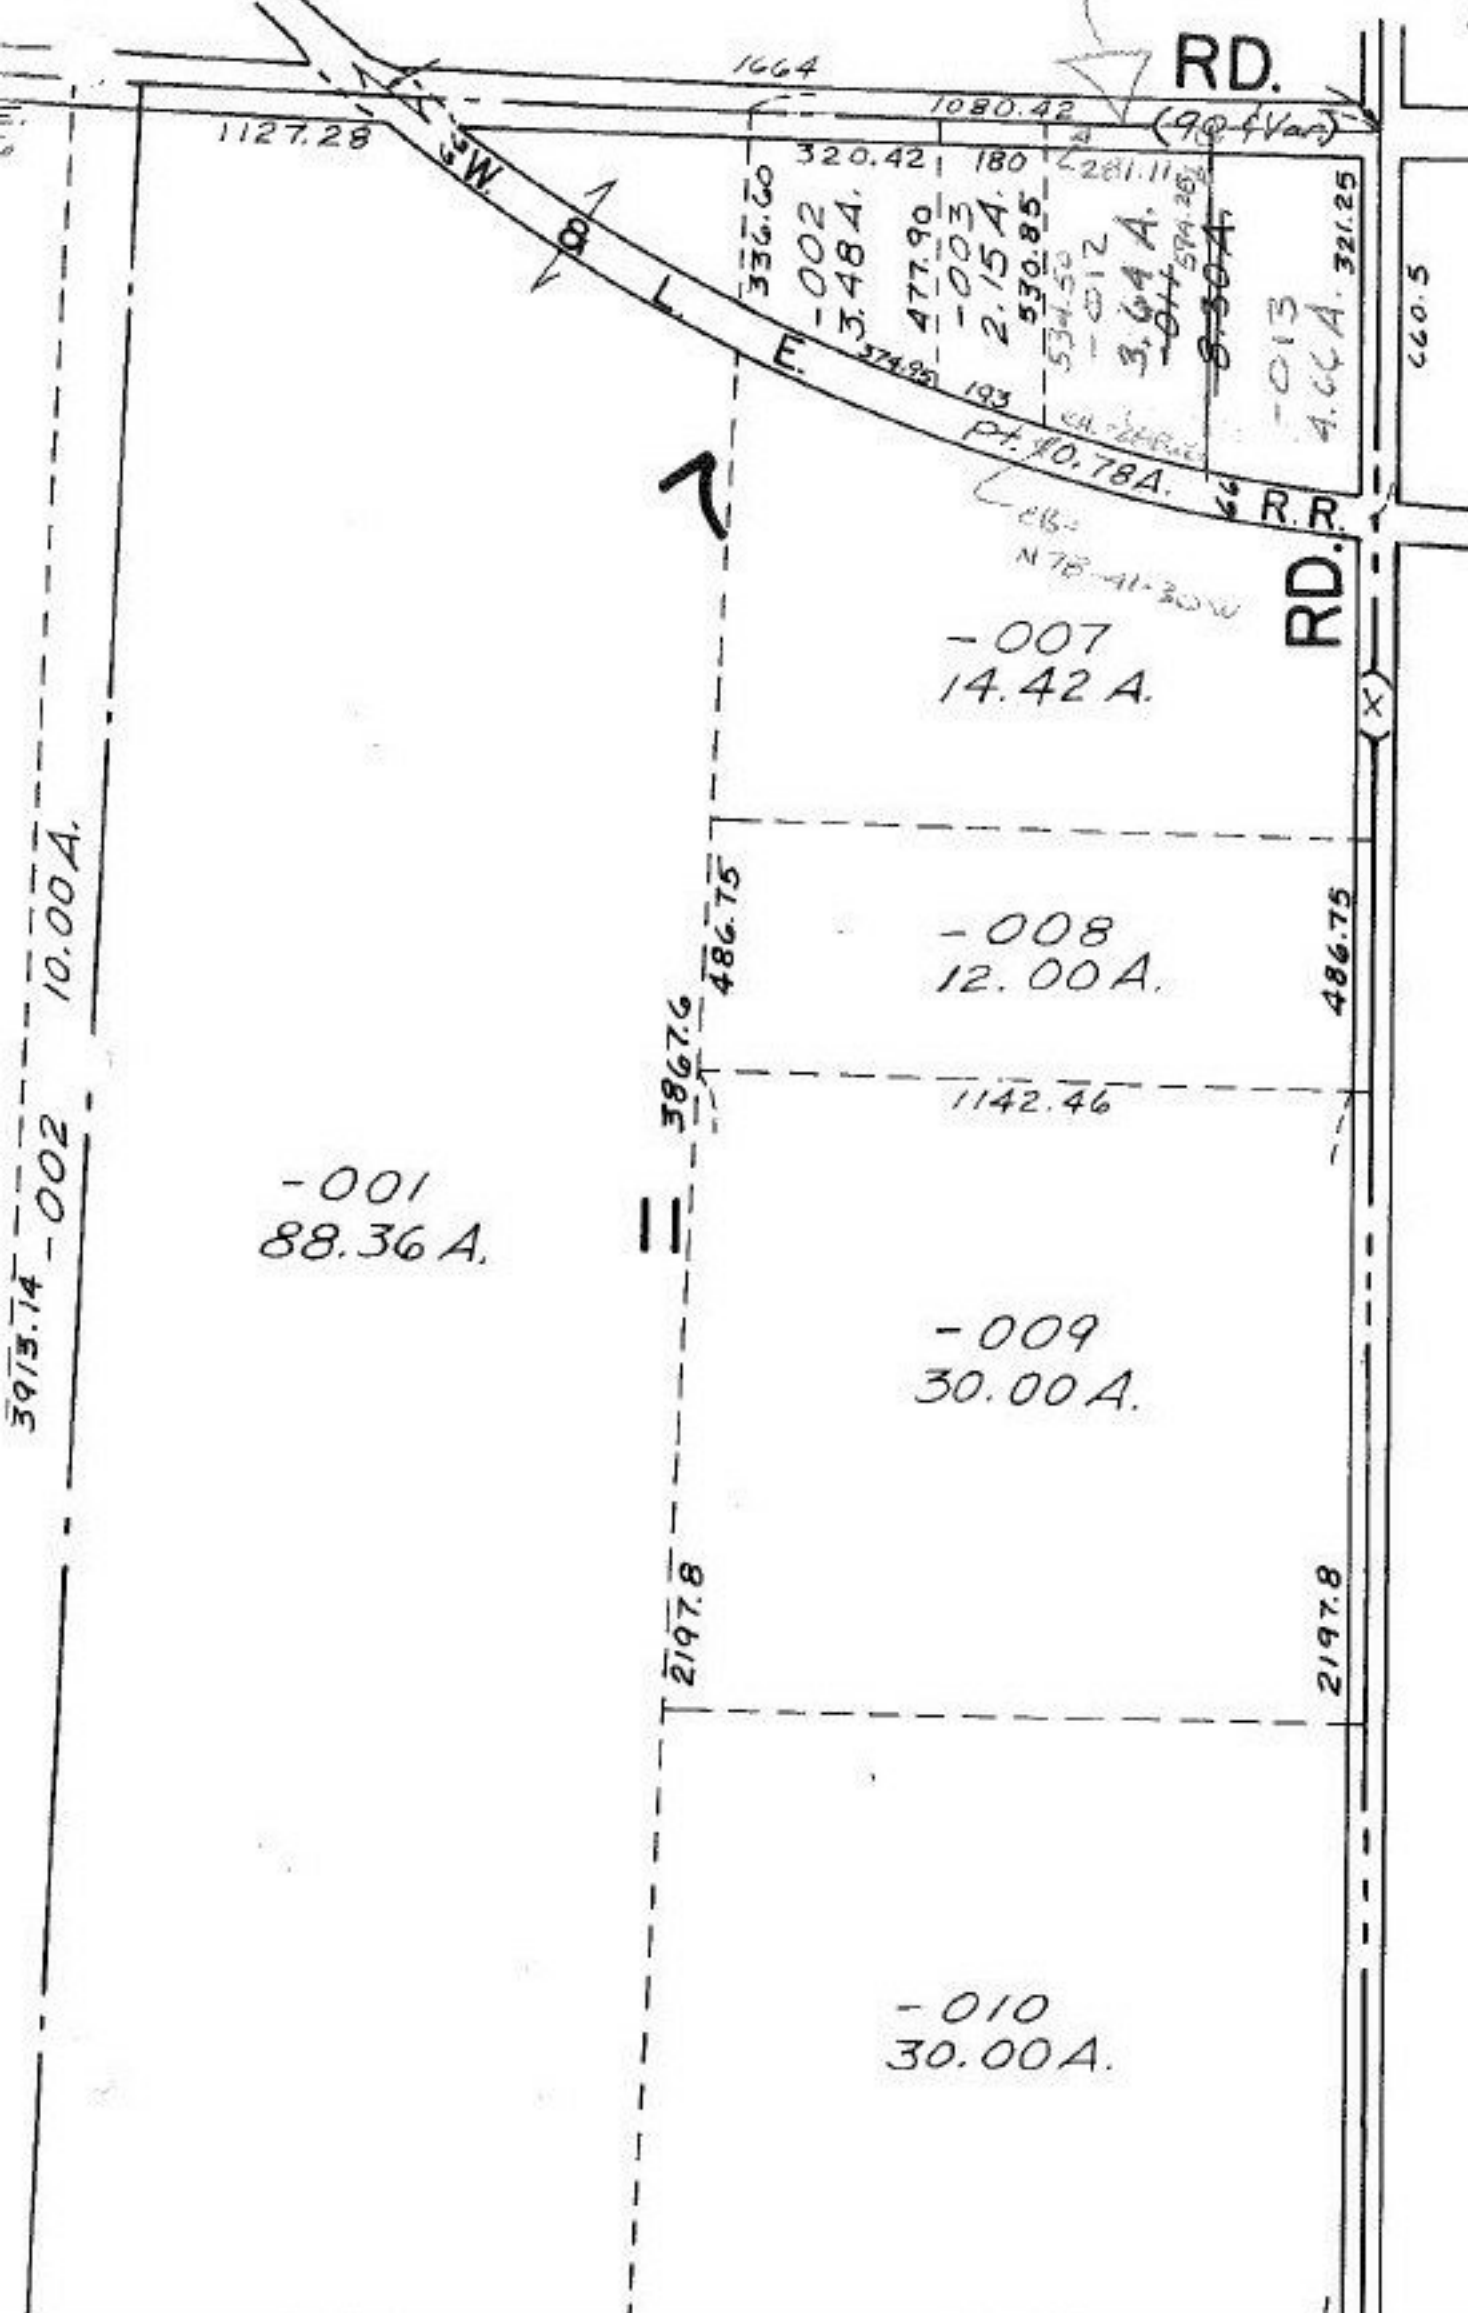

12-16-86
#16893

APPROVED	
LORAIN CO.	
MAP DEPT.	
DATE 8-13-86	
PAGE 17-H	
BY T. McMan	
VOID	
AFTER	