


1691
11-25-67
11-25-67

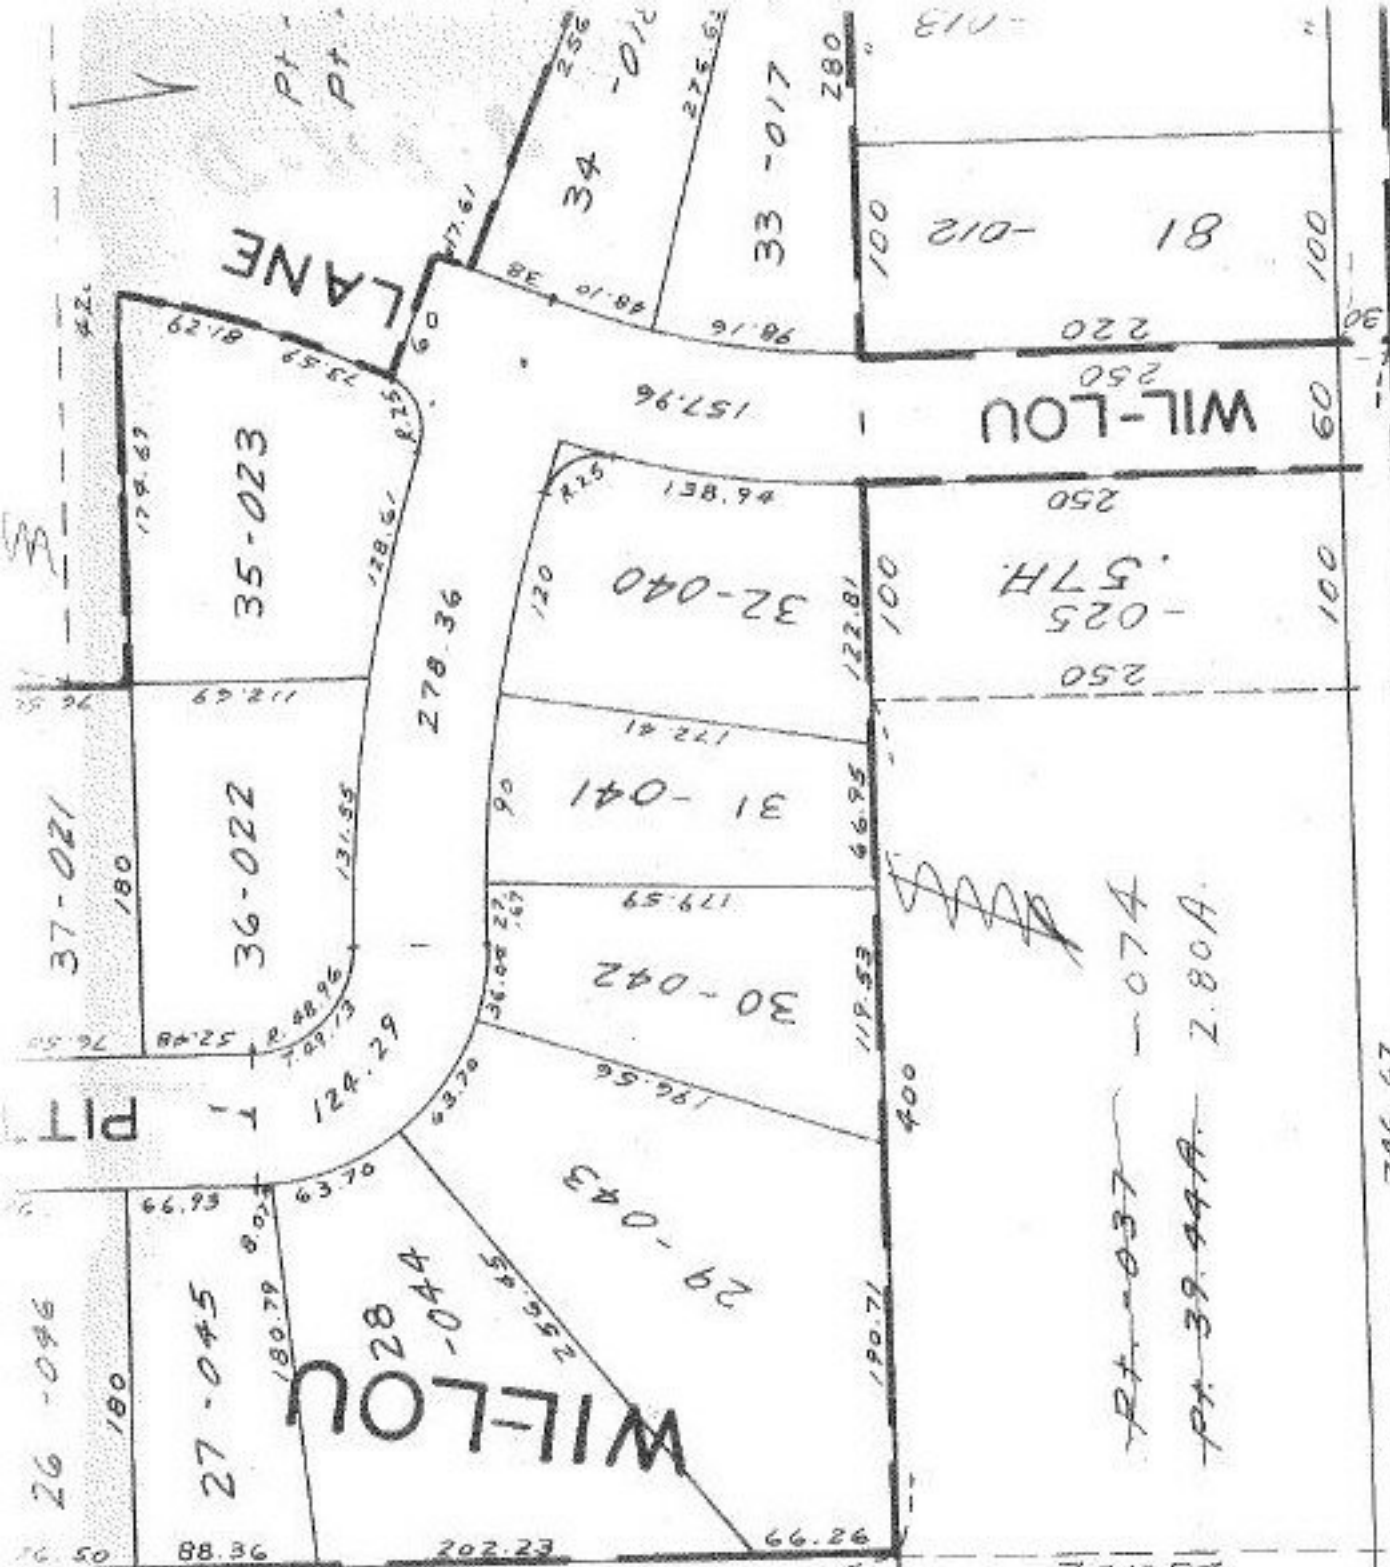

SEE 7-00-015

BAINBRIDGE - 746.67

1691

APPROVED
 LORAIN CO.
 MAP DEPT.
 DATE 4-19-68
 7-00-016-D
 BY D. Maynard

7-3086
 L.L.



DONE 7/8/68 W. Kochis