


1692
 6-4-87 08

ROAD RECORD Vol. 3 P. 542 30

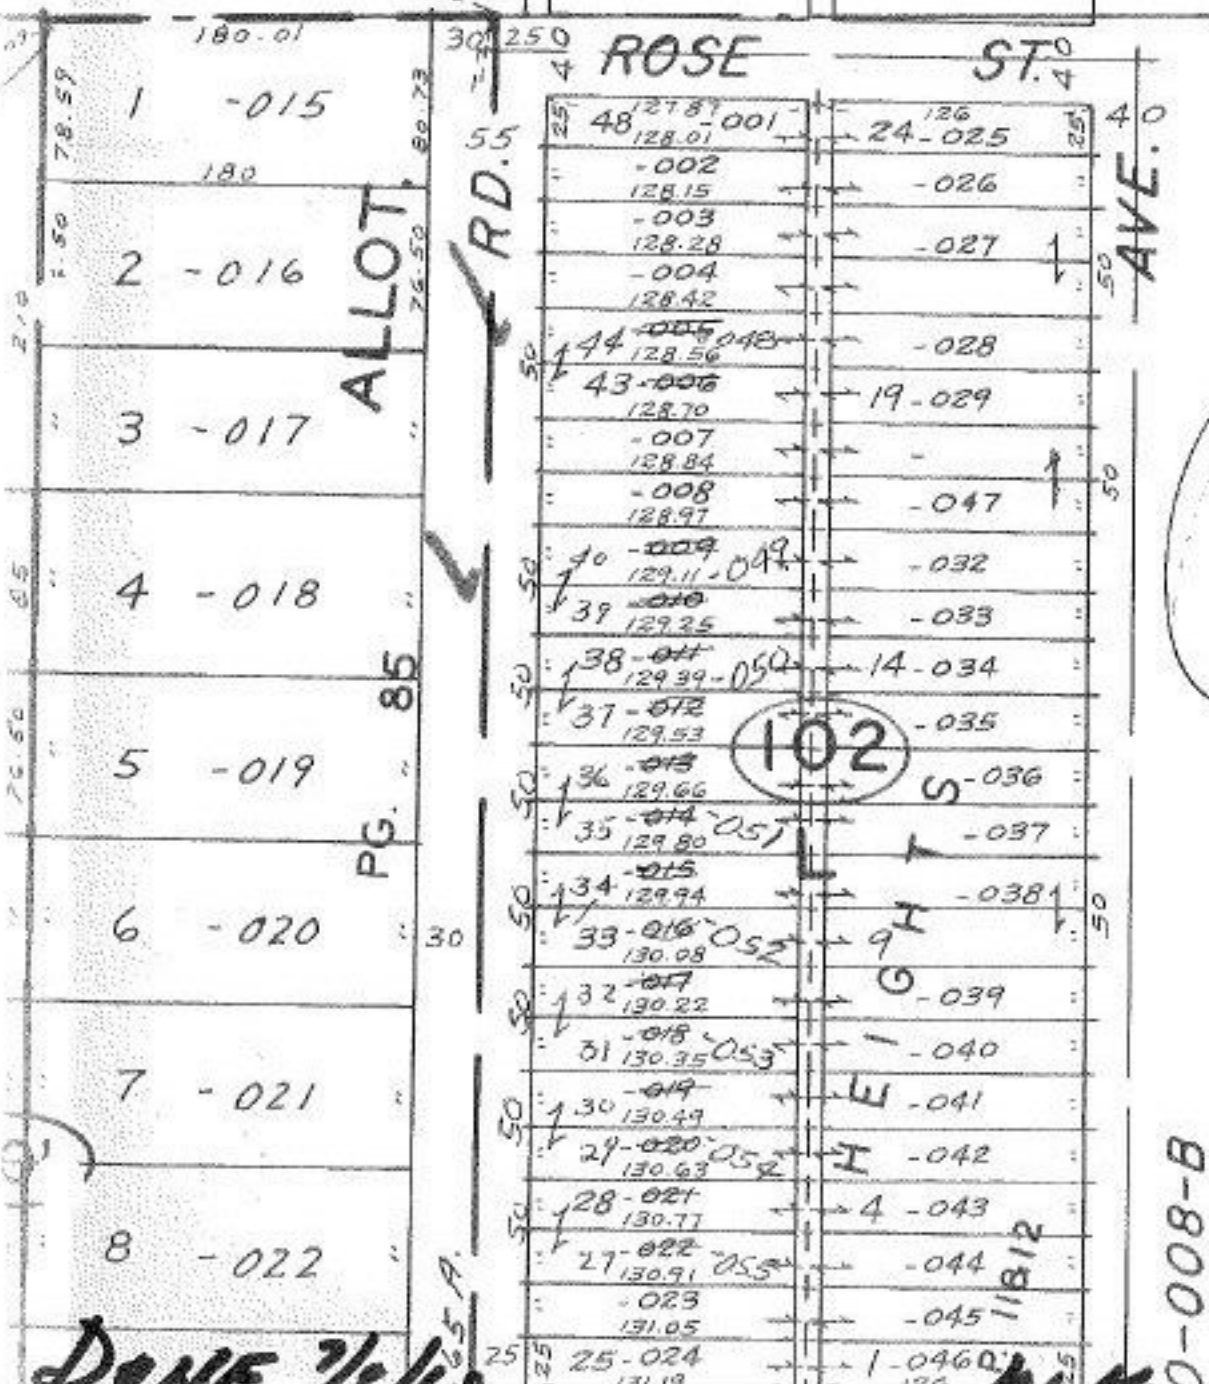

1692

APPROVED
 LORAIN CO.
 MAP DEPT.
 DATE 4-23-68
 7-00-008-A
 BY
L. Colby

DONE 2/1/68

0-008-B