


04-00-008-101
Prior Deeds 900-187 902-275 938-875 1193-807
Surveyed by K.S.A
C=LINE

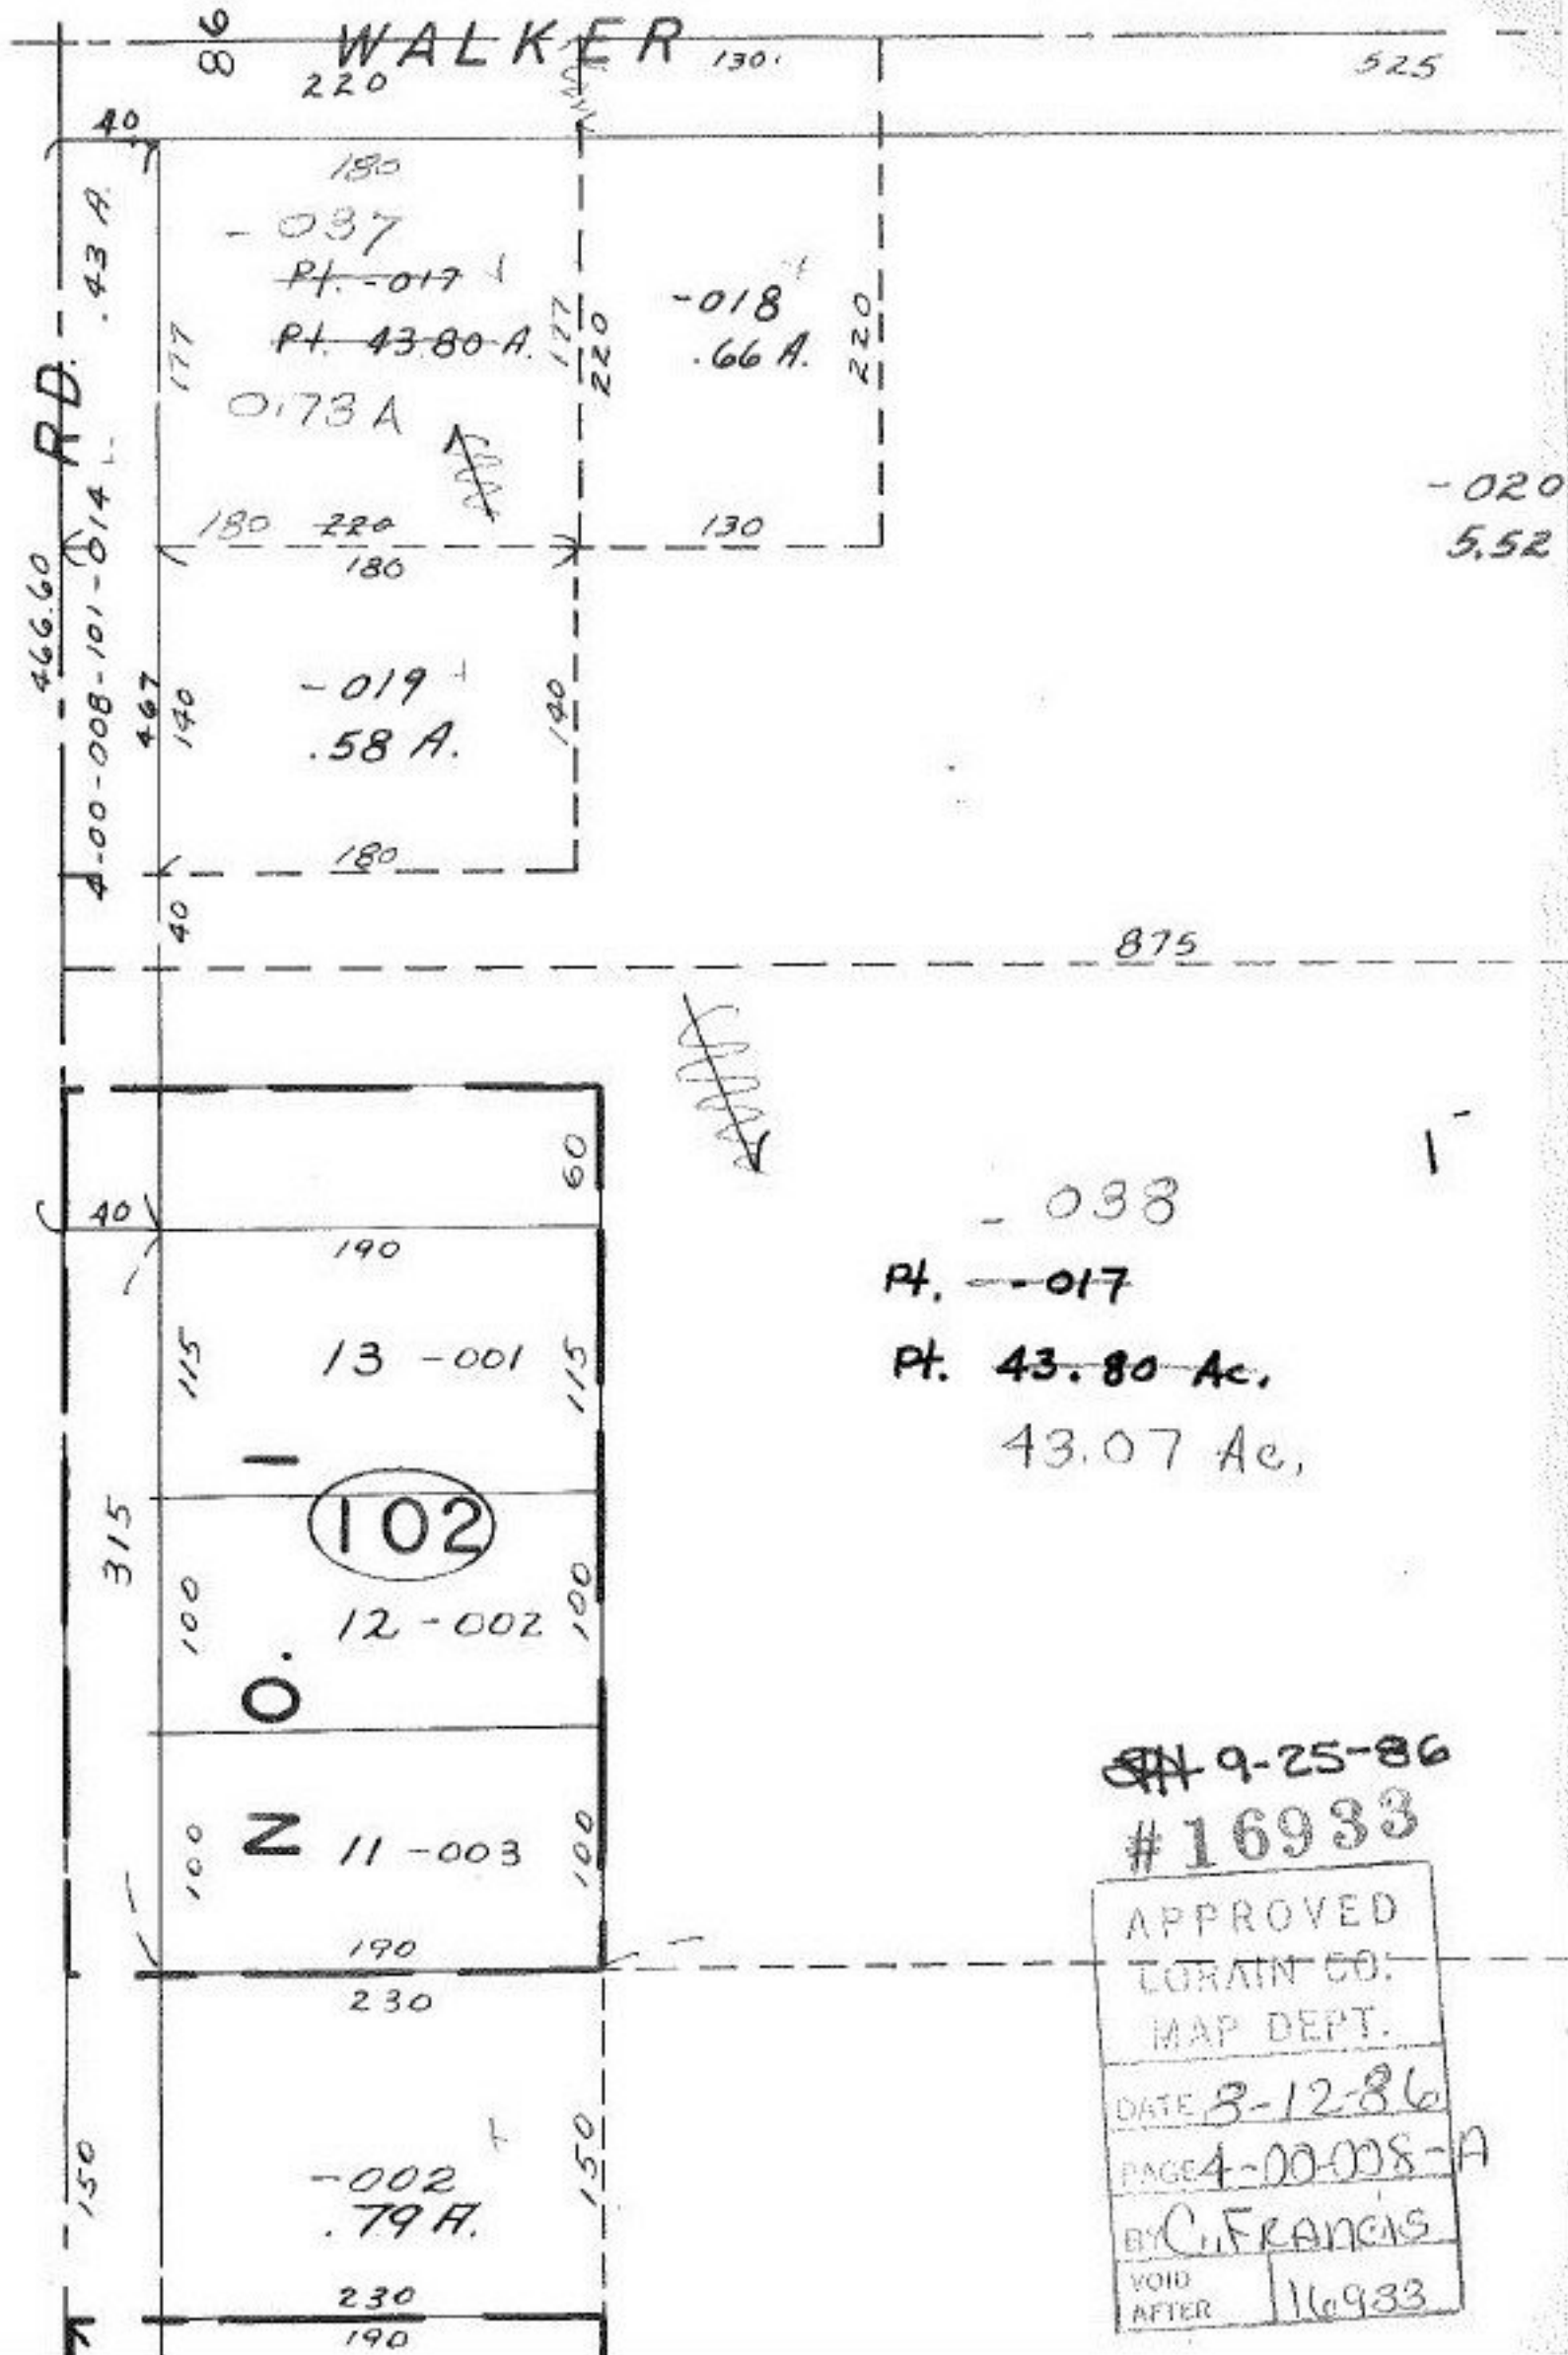

- 038
Pt. -017
Pt. 43.80 Ac.
43.07 Ac.

~~9-25-86~~
#16933

APPROVED
LORAIN CO.
MAP DEPT.
DATE 3-12-86
PAGE 4-00-008-A
BY C. FRANCIS
VOID AFTER 16933