


06-23-005-102

Prior Decd 1384/275

Surveyed By: Mc G Linchy & Assoc.
C=1:142857,

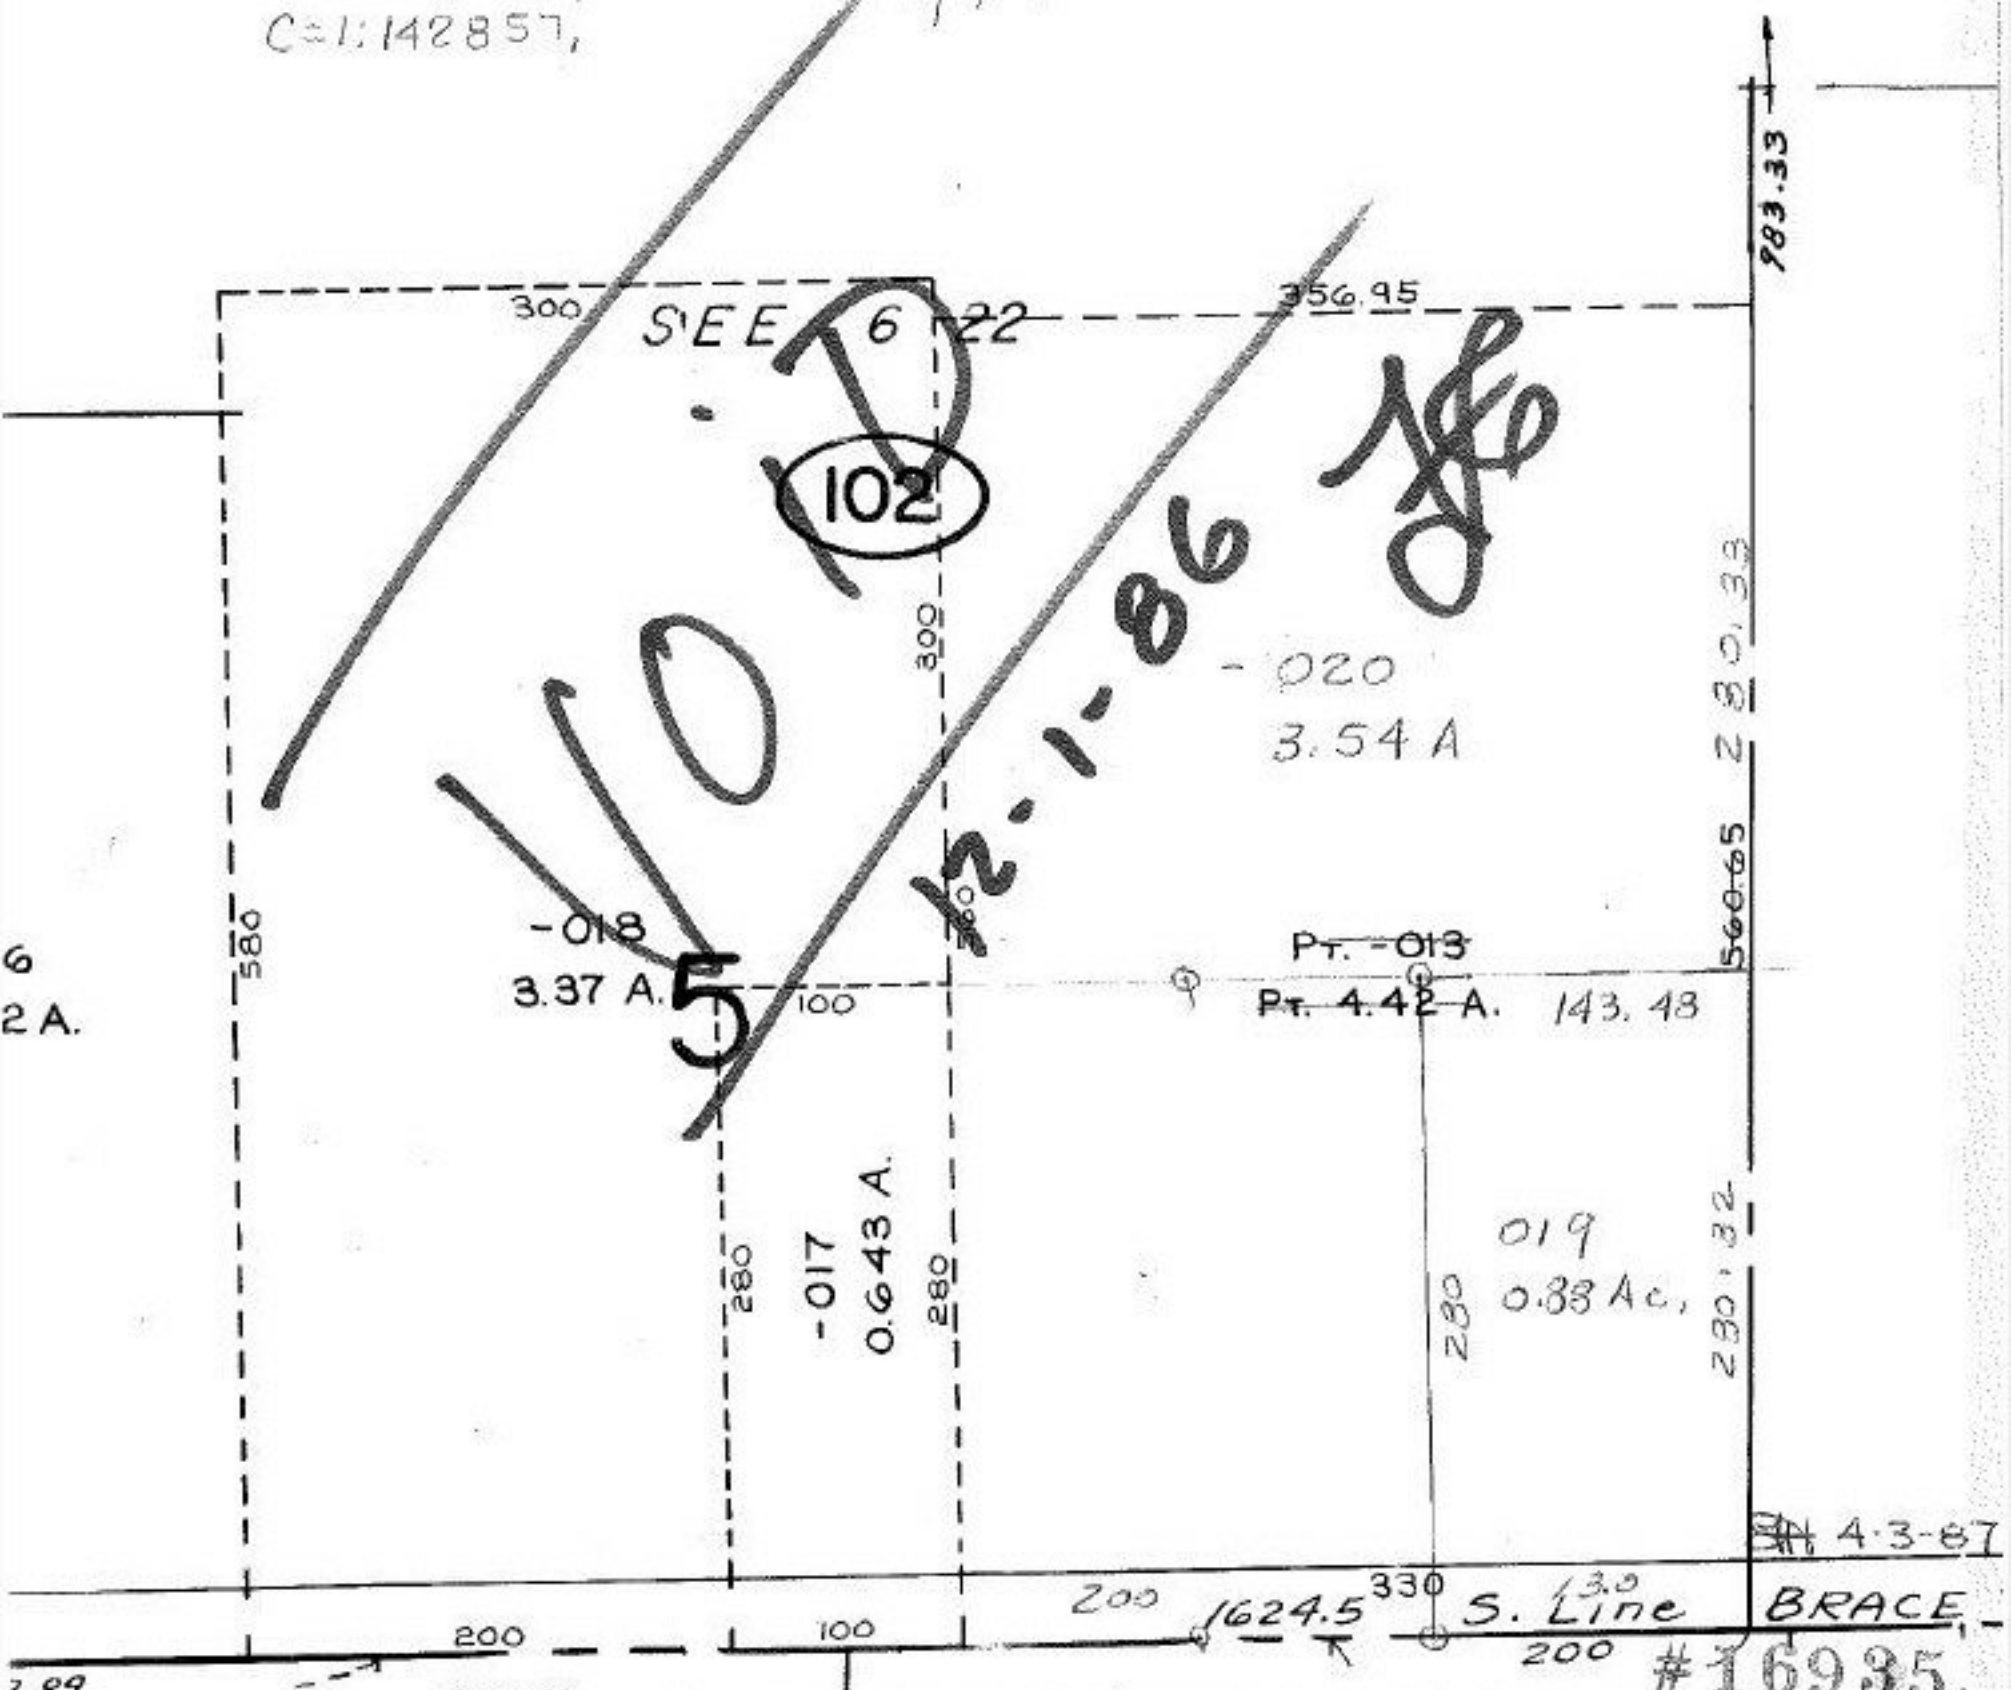

APPROVED
LORAIN CO.
MAP DEPT.
DATE 8-12-01
PAGE 33
#16935