


SEE 10-00-025-G

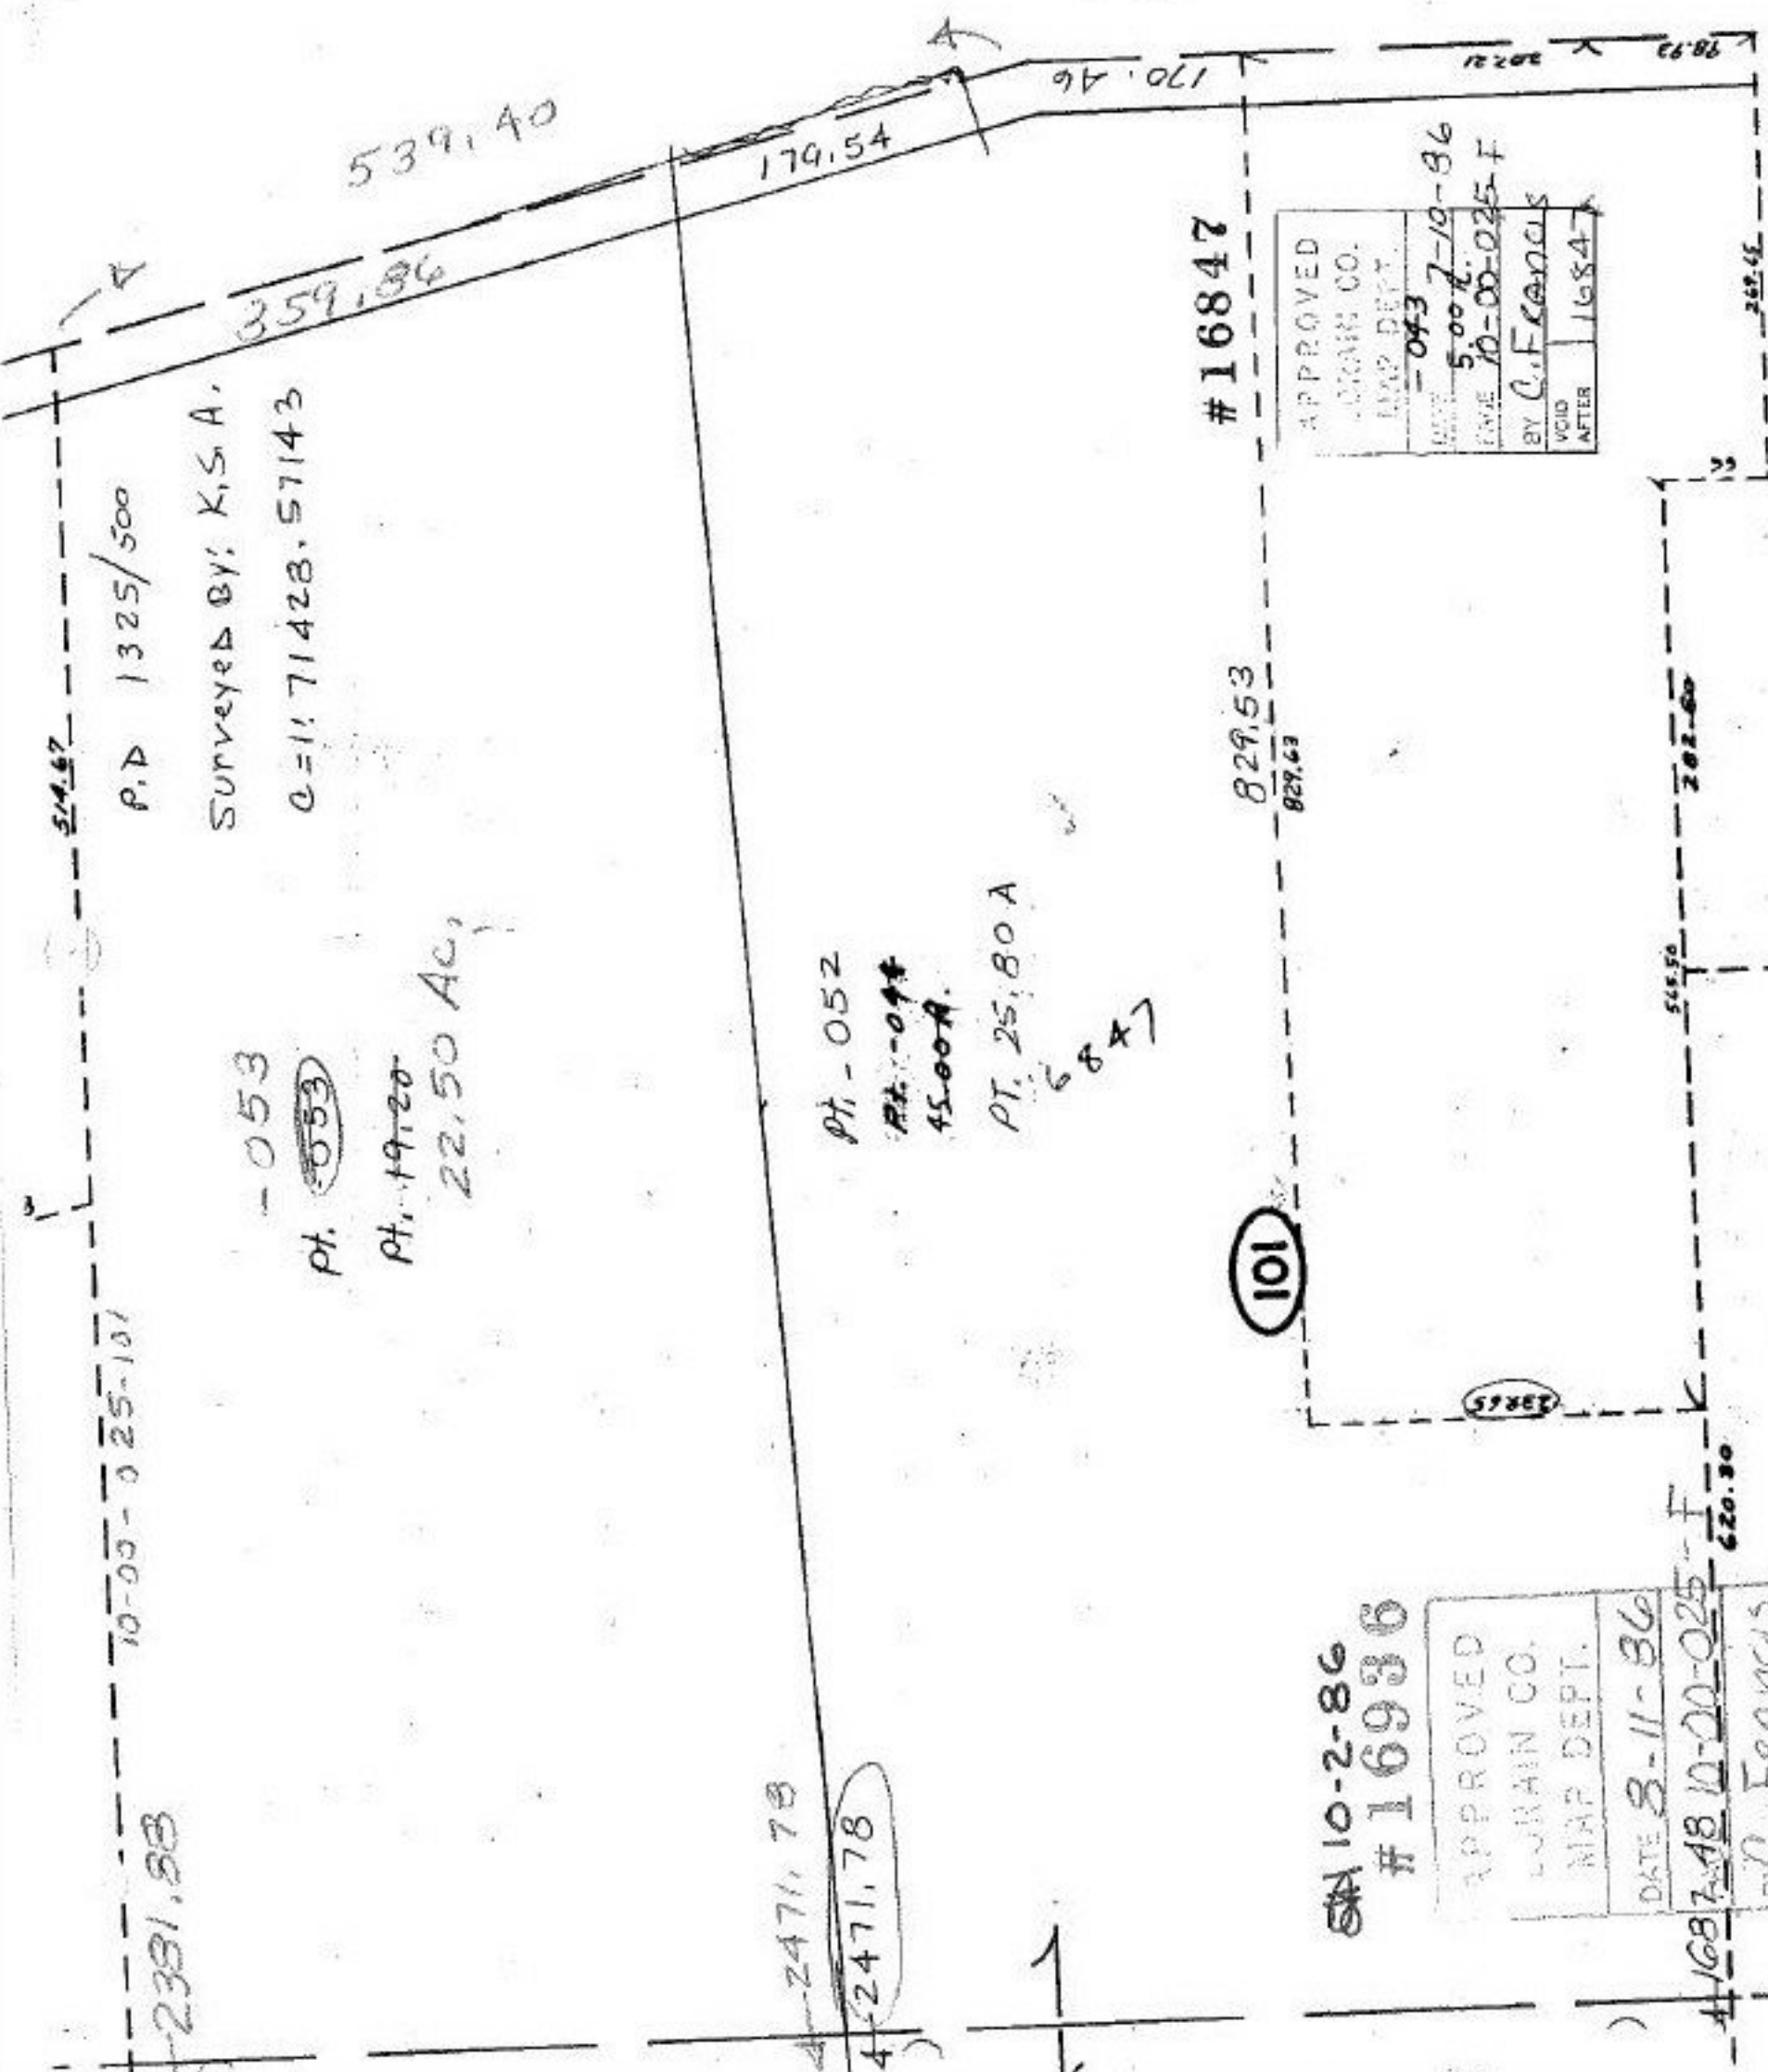

514.67

P.D 1325/500

Surveyed BY: K.S.A.

C=1: 71428, 57143

539.40

359.86

179.54

170.46

282.21

-053

Pt. 053

Pt. 19.20

22.50 AC.

Pt. -052

Pt. -094

45.00A.

Pt. 25.80 A

6847

16847

829.53

829.63

101

APPROVED
LURAIN CO.
MAP DEPT.
DATE 5-00-7-10-86
BY C. FRANCIS
VOID AFTER 16847

10-2-86
16936

APPROVED
LURAIN CO.
MAP DEPT.
DATE 3-11-86
BY C. FRANCIS
VOID AFTER 16936

DATE 3-11-86

BY C. FRANCIS

VOID AFTER 16936

10-00-025-F

620.30

545.50

202.60

262.45

10-00-025-F