


06-22-009-101

Prior Deed 1246-351  
Surveyed by: JOHN POZYWAK

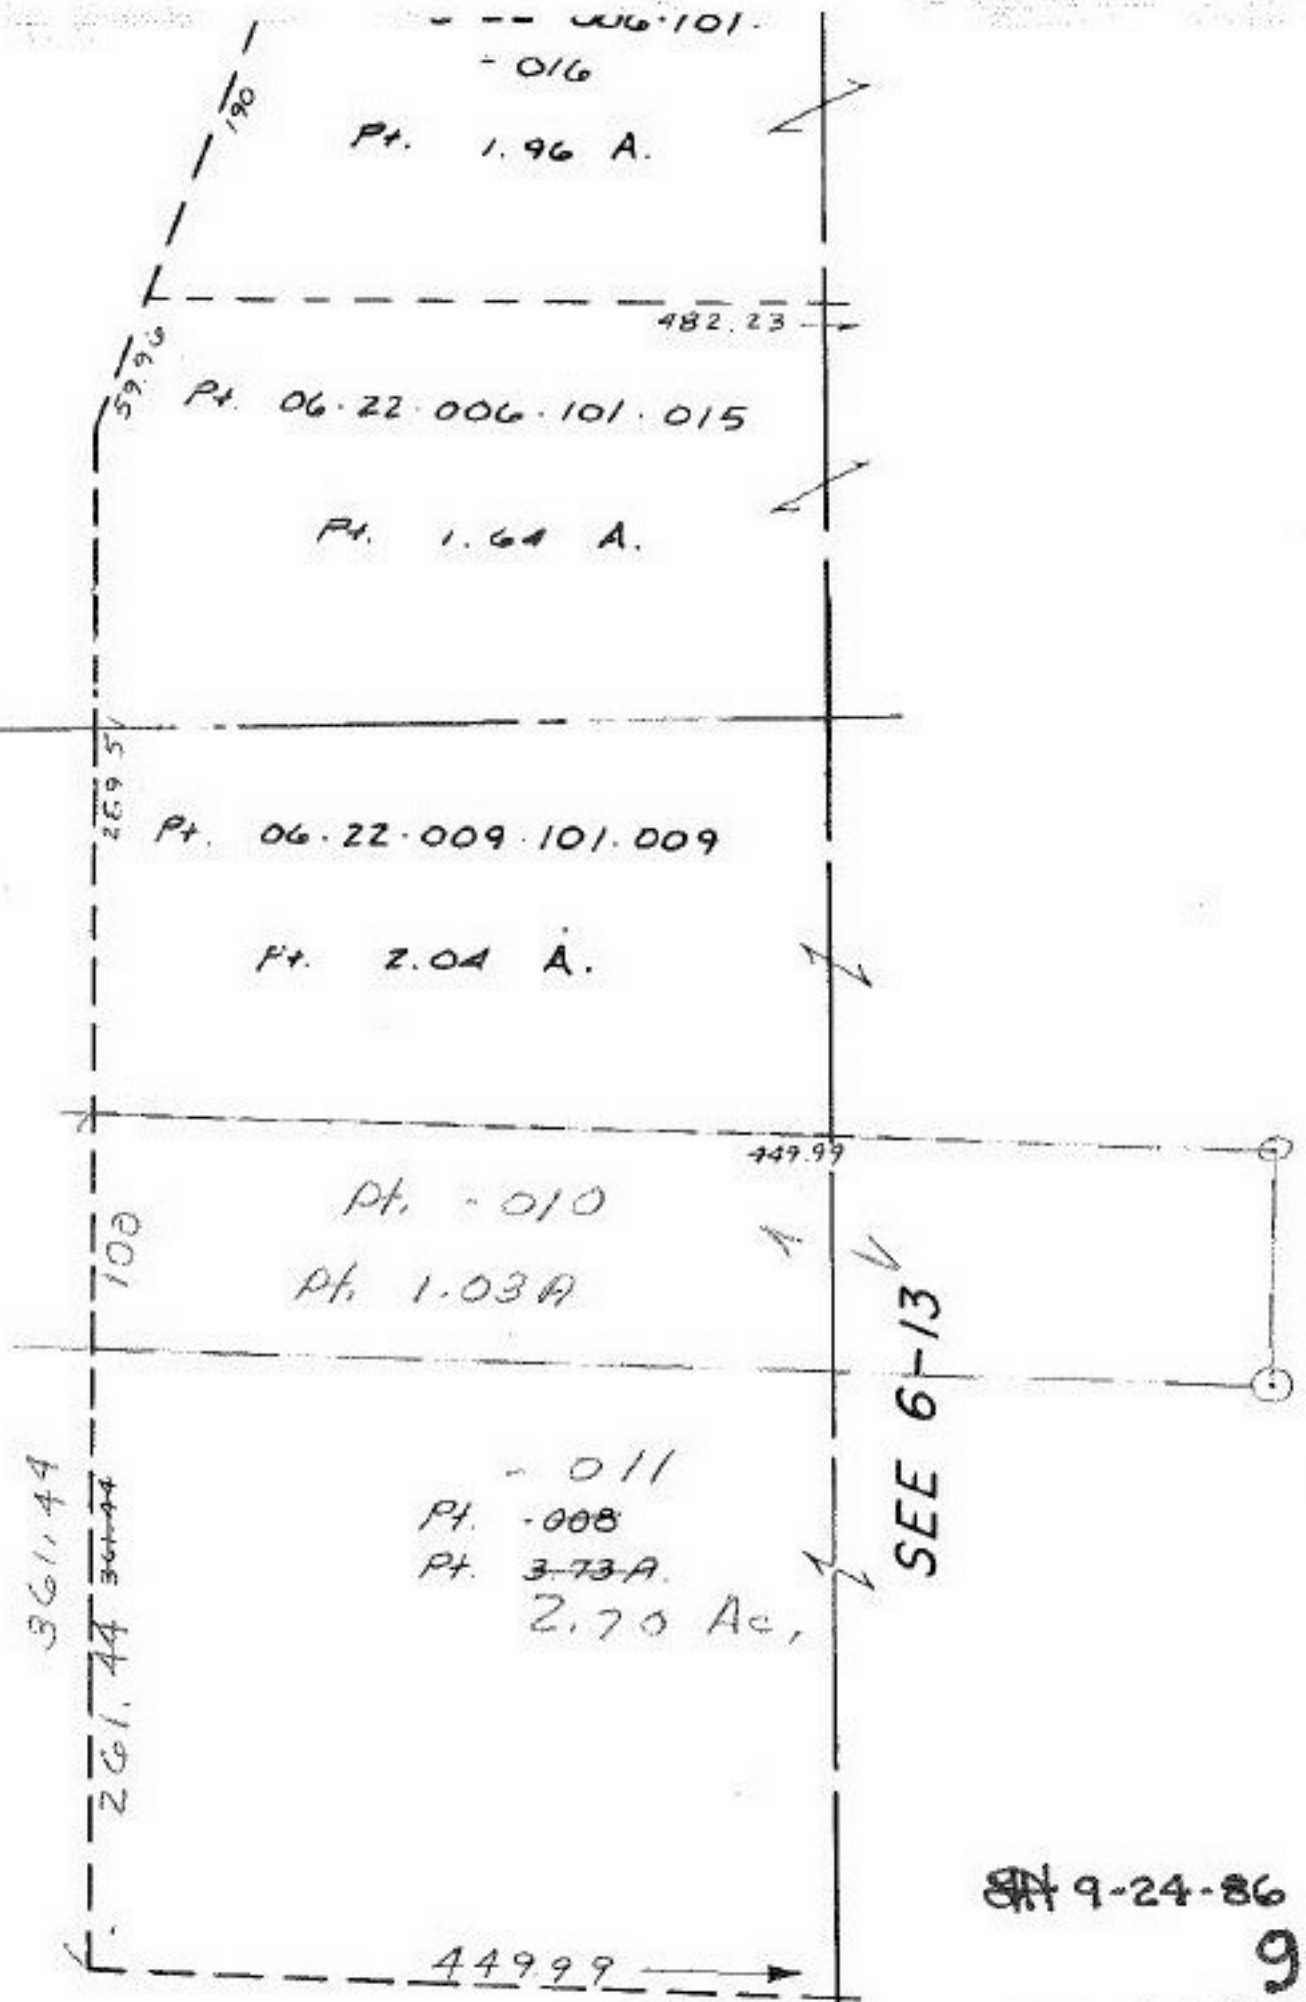

~~9-24-86~~  
9  
#1693

APPROVED	VOID
BY	LORAIN CO.
PAGE	MAP DEPT.
DATE	8-12-86
PAGE	6-12-86
BY	C. FRANCIS
VOID	16939
AFTER	