

#1 47 x 90


#2 37 x 100

#3 40 x 107.5

+ except (50 x 50)

SEE 2-01-004-B

LEAVE -003
PARCEL #1
PARCEL #2

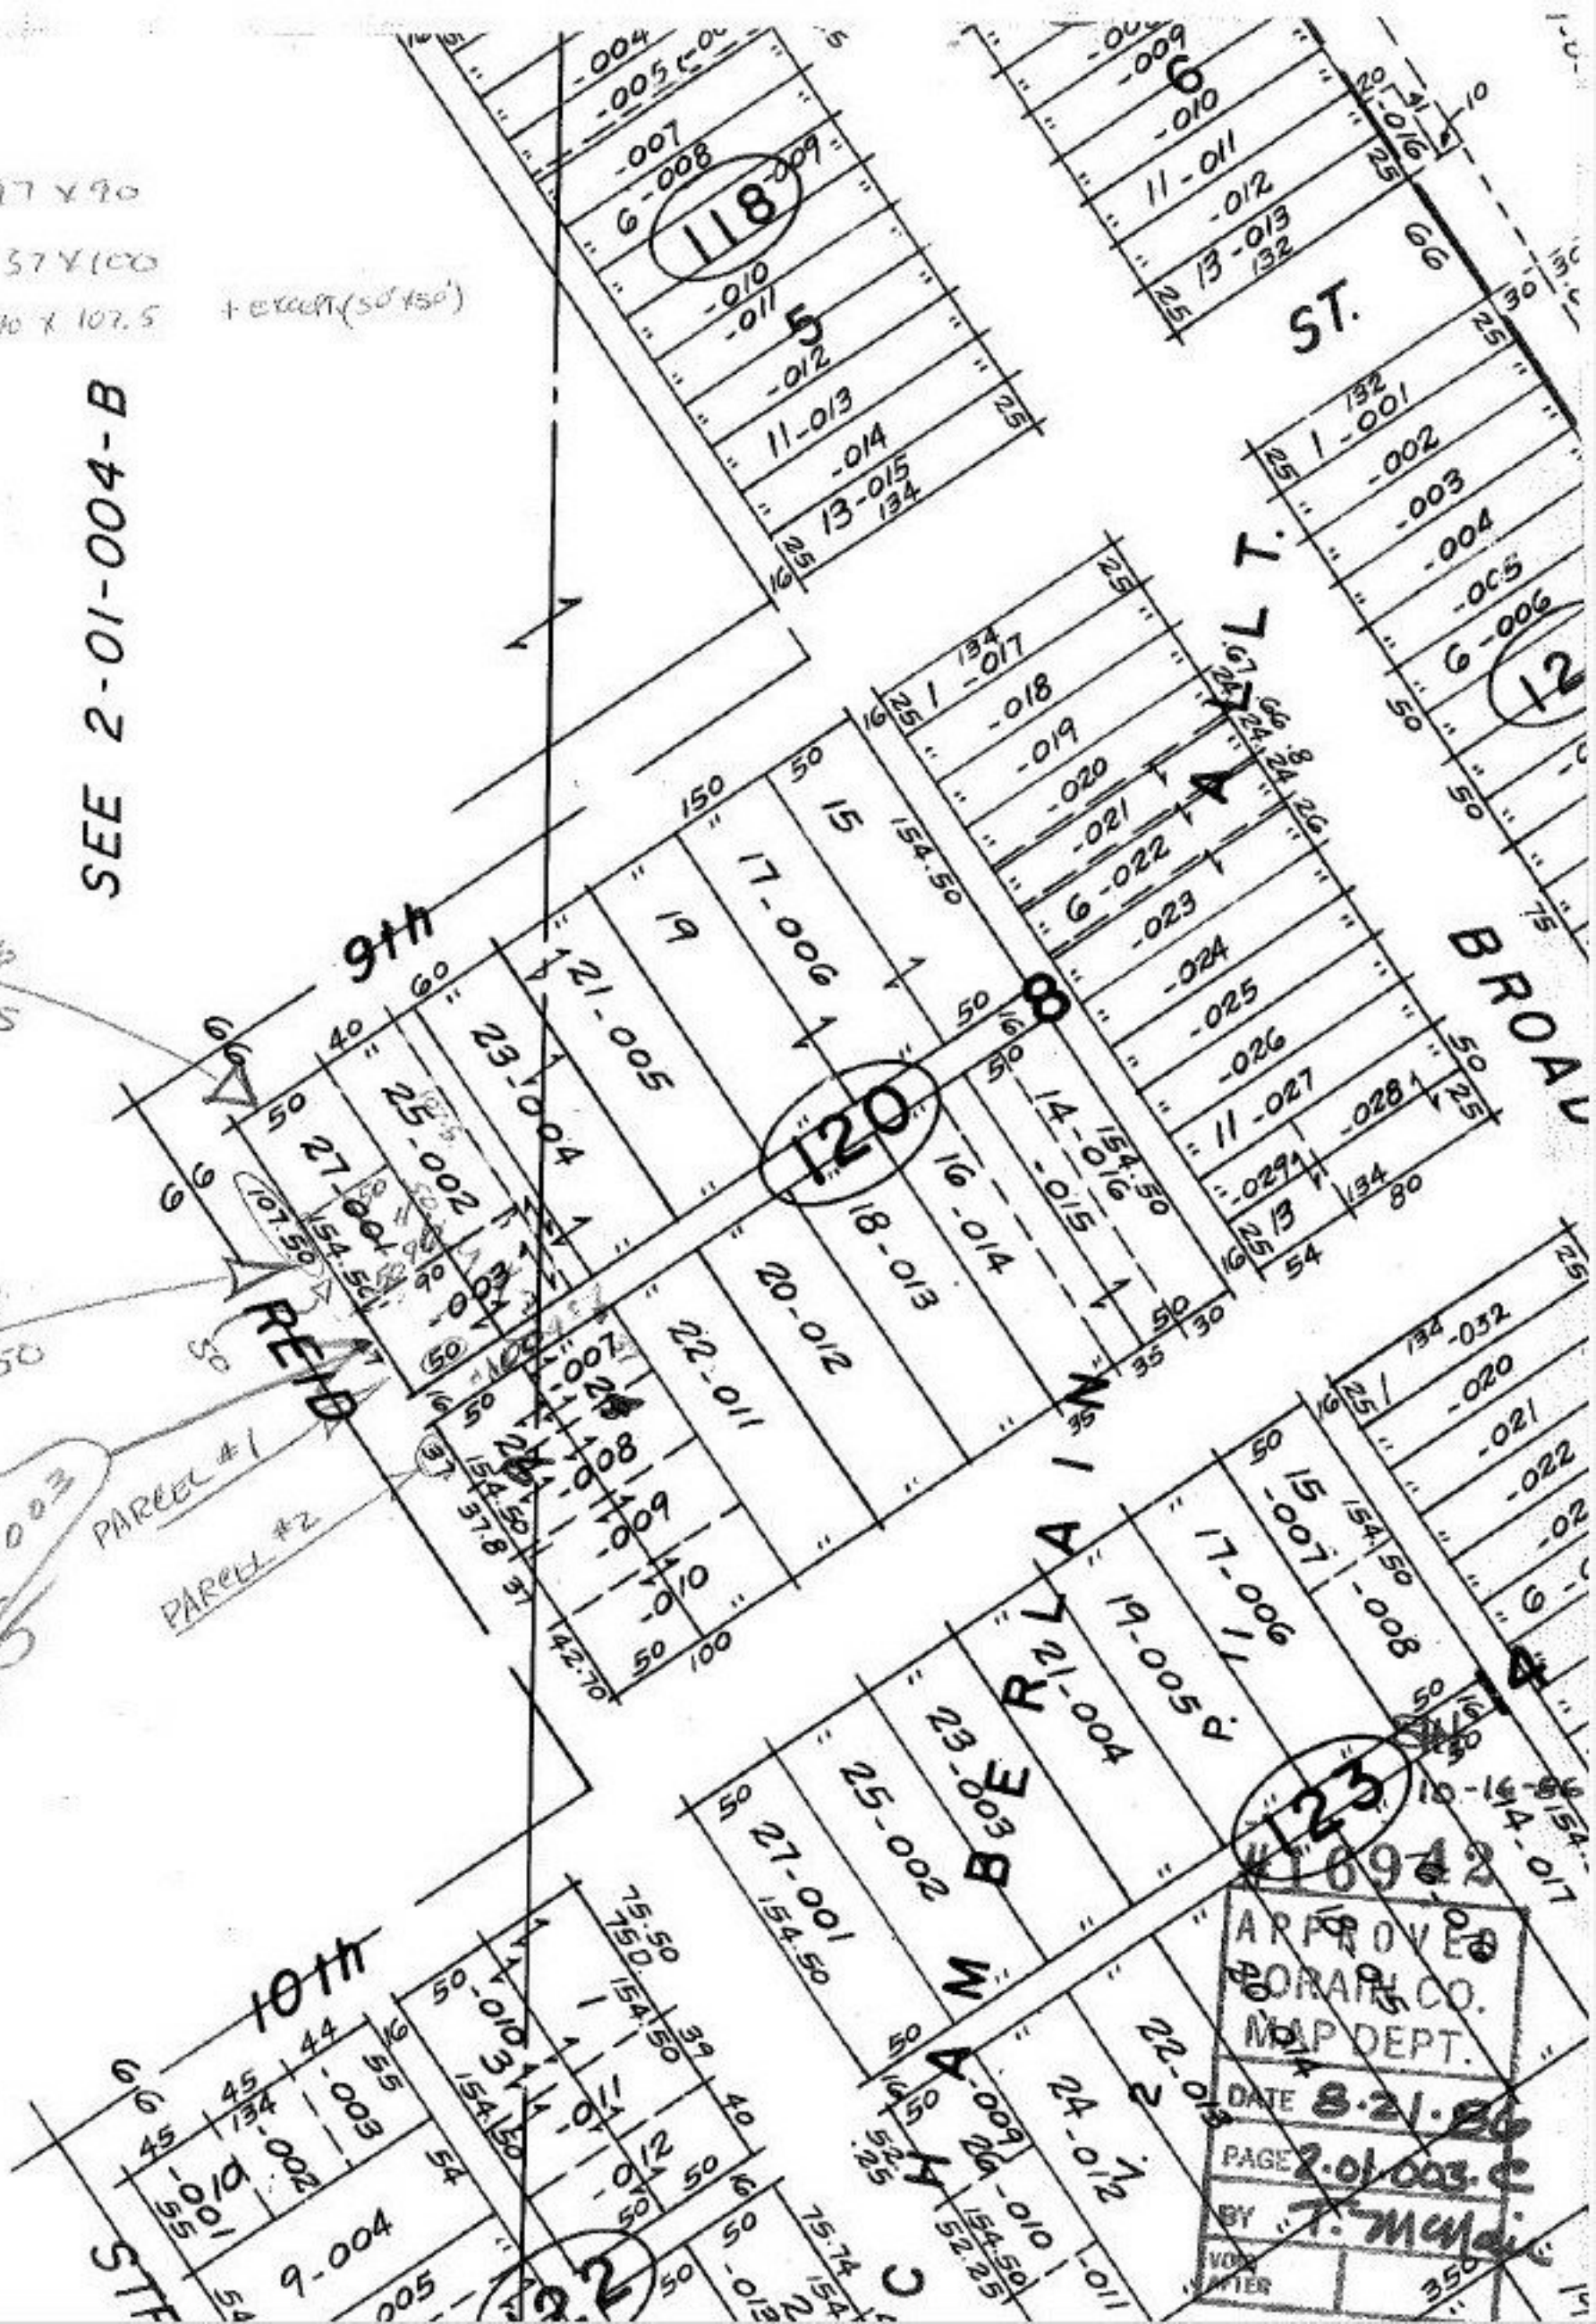

APPROVED
 BORAN CO.
 MAP DEPT.
 DATE 8-21-86
 PAGE 2-01-003-C
 BY T. McNeil
 VON
 AFTER