


04-00-027-101-

3212.51

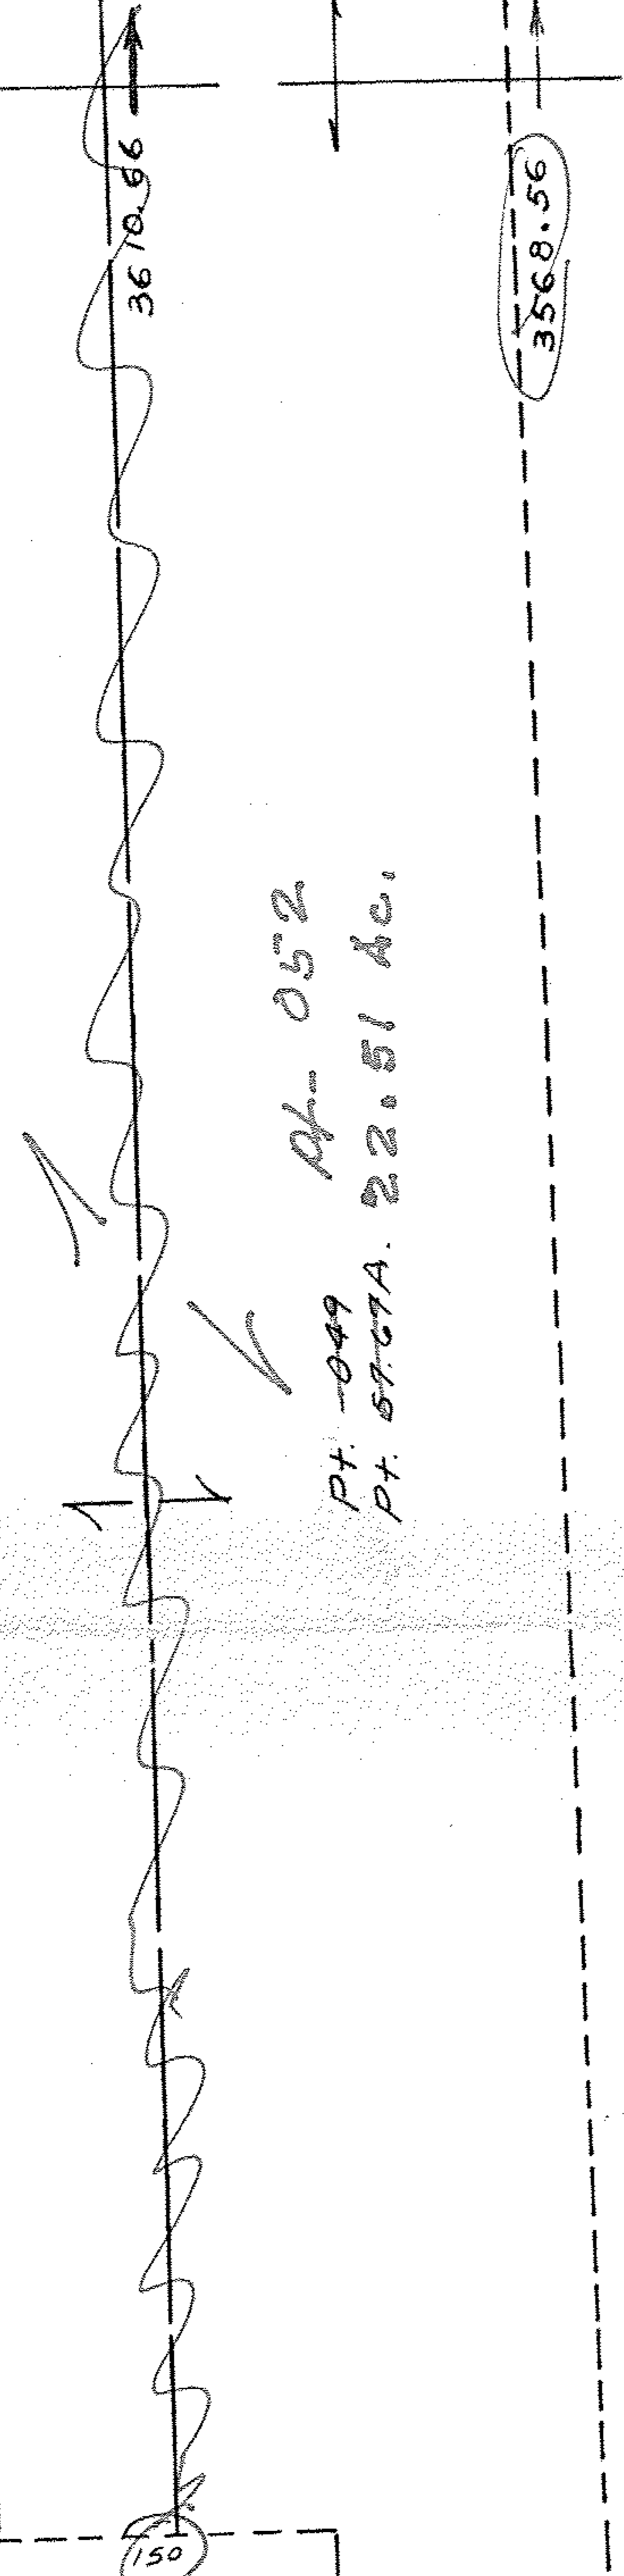

Pt. -049
Pt. -052
Pt. 57-07A. 22.51 Ac.

Pt. -007
Pt. 16.45 A.

3526.29
2956.80
3524.95

Pt. -039
Pt. 5.51 A.

800

10

413.30
-048
1.38 A.

385.76

9-25-86
#16985

APPROVED
LORAIN CO.
MAP DEPT.
DATE 9-9-86
PAGE 4-00-027-F
C. FRANCIS
VOID AFTER 16985

856.09

27-E

53.450
152.3

143.48
NORTH RIDGE
88.66
1380

620.38
179.93

181.61
181.57
-013
-040
-040
200

67.56
107°32'43"

A.

65
-040
-040