


11-30-87 *CF*



~~022~~  
16.19A.  
-027  
~~11.51A.~~  
11.51A.

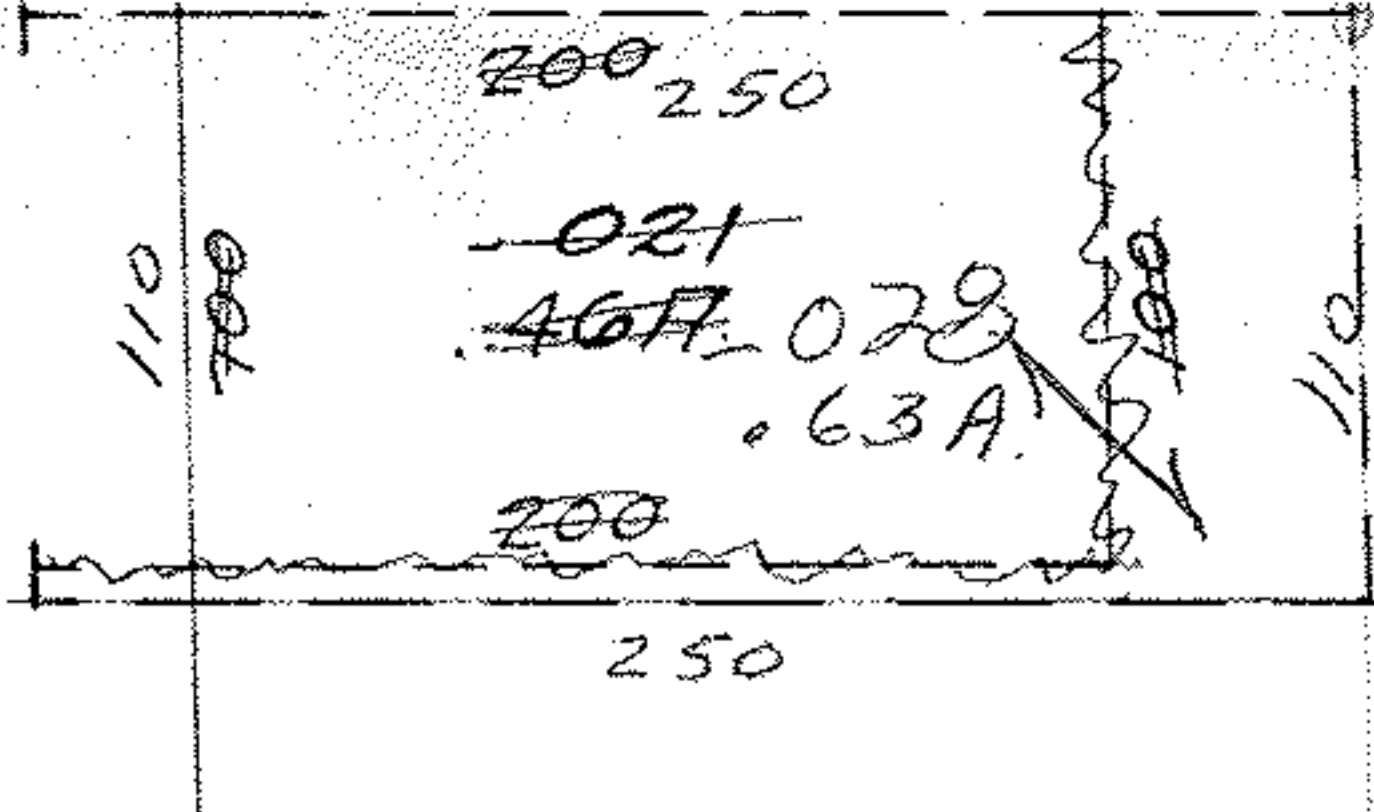


1699

7-15-86 88  
APPROVED  
LORAIN CO.  
MAP DEPT.  
DATE 4-23-68  
5-00-052-B  
BY  
*Hollert*


Done 7-19-68  
*John Grace*

OBERLIN

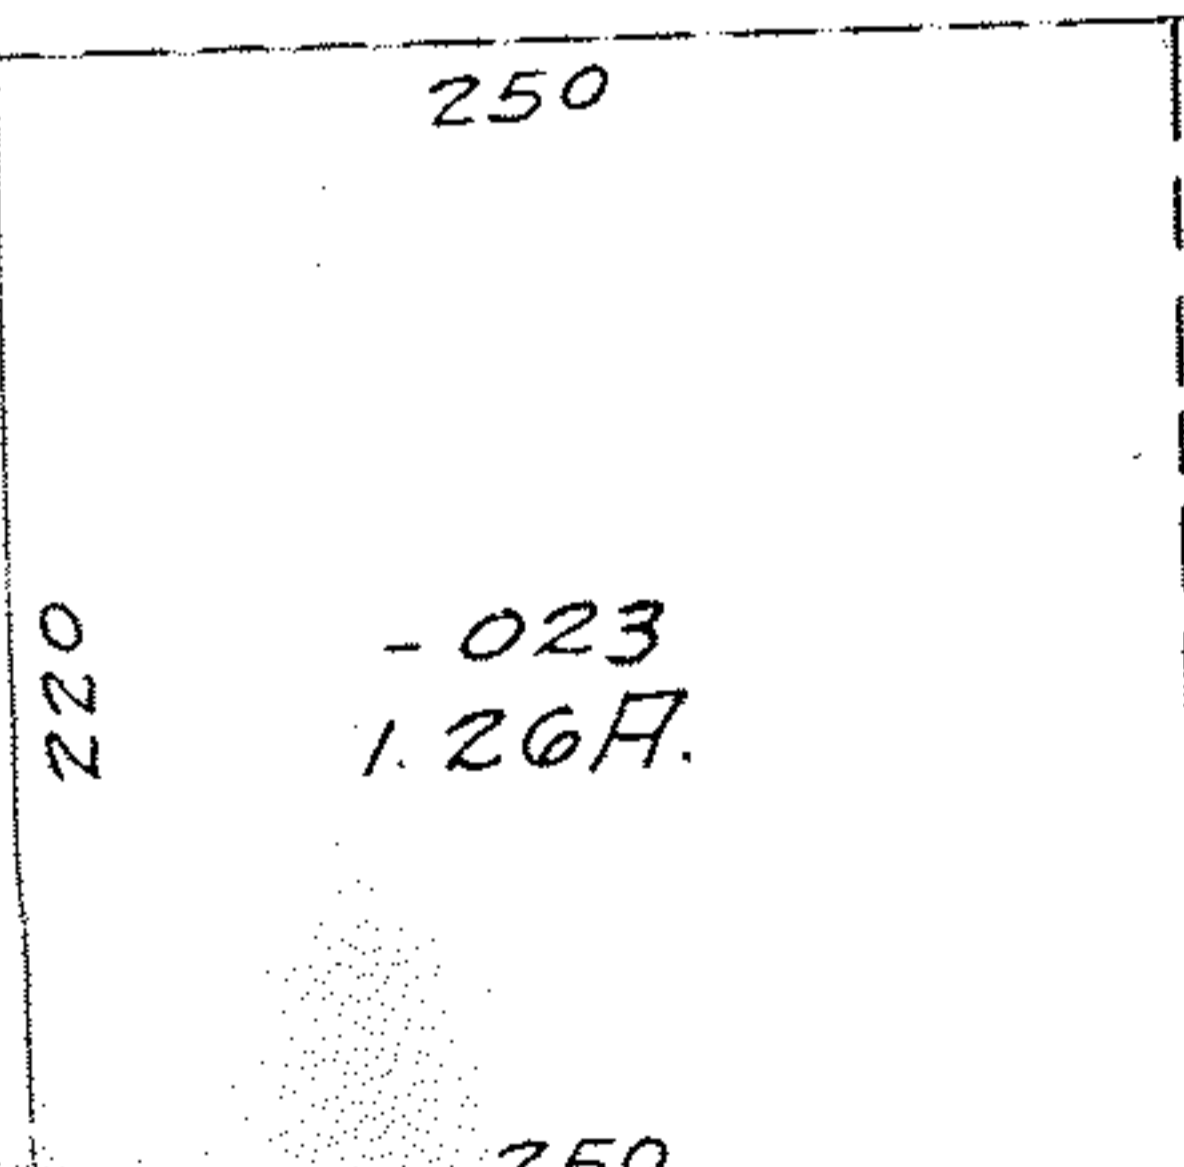

882.00

-026  
4.51A.

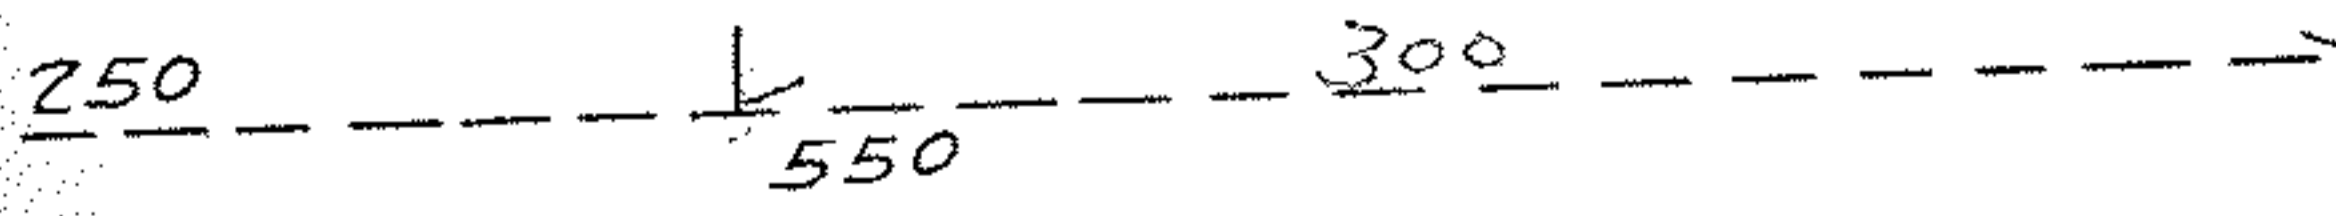

-025  
1.44A.

588.97