


COWLEY

RD.

57

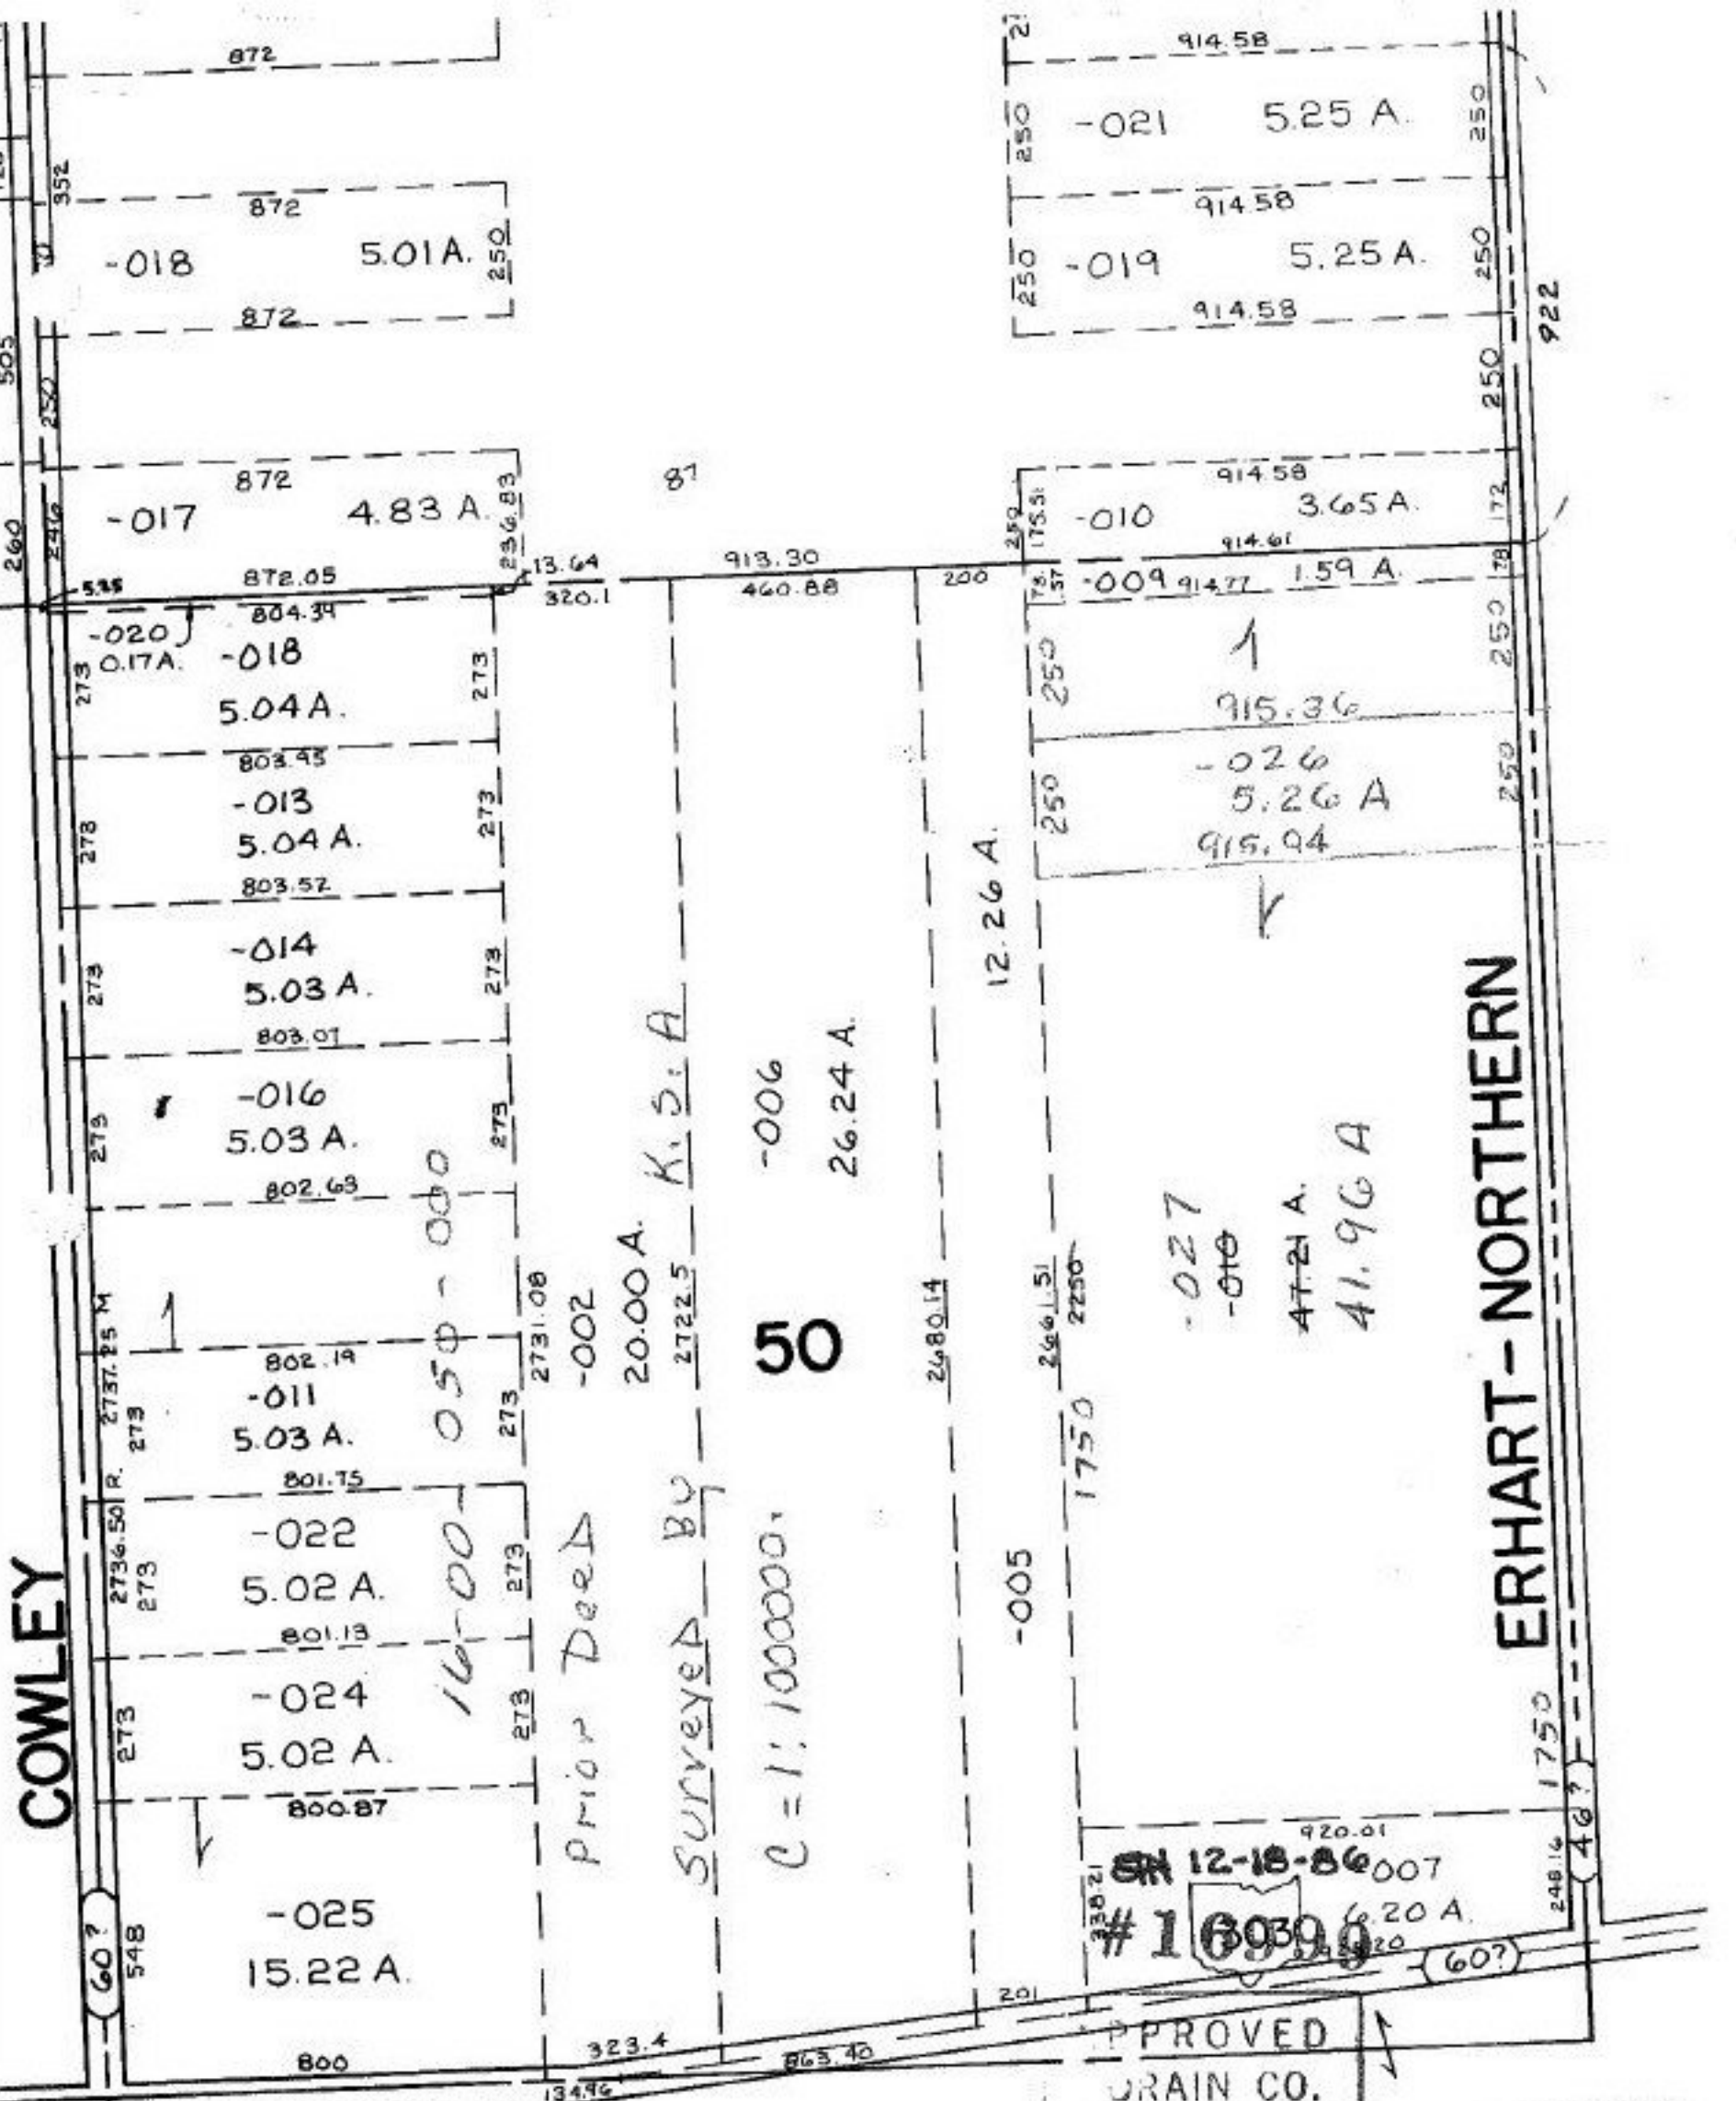

32821
 12-18-86
 # 160399
 920.01
 620 A.
 248.14
 (60?)

APPROVED
 GRAIN CO.
 MAP DEPT.

DATE 9-12-86
 PAGE 16-D
 BY C. FRANCIS
 VOID 11.900

REVISED
 7-28-86
16-D