


# COMBINATION

#16992

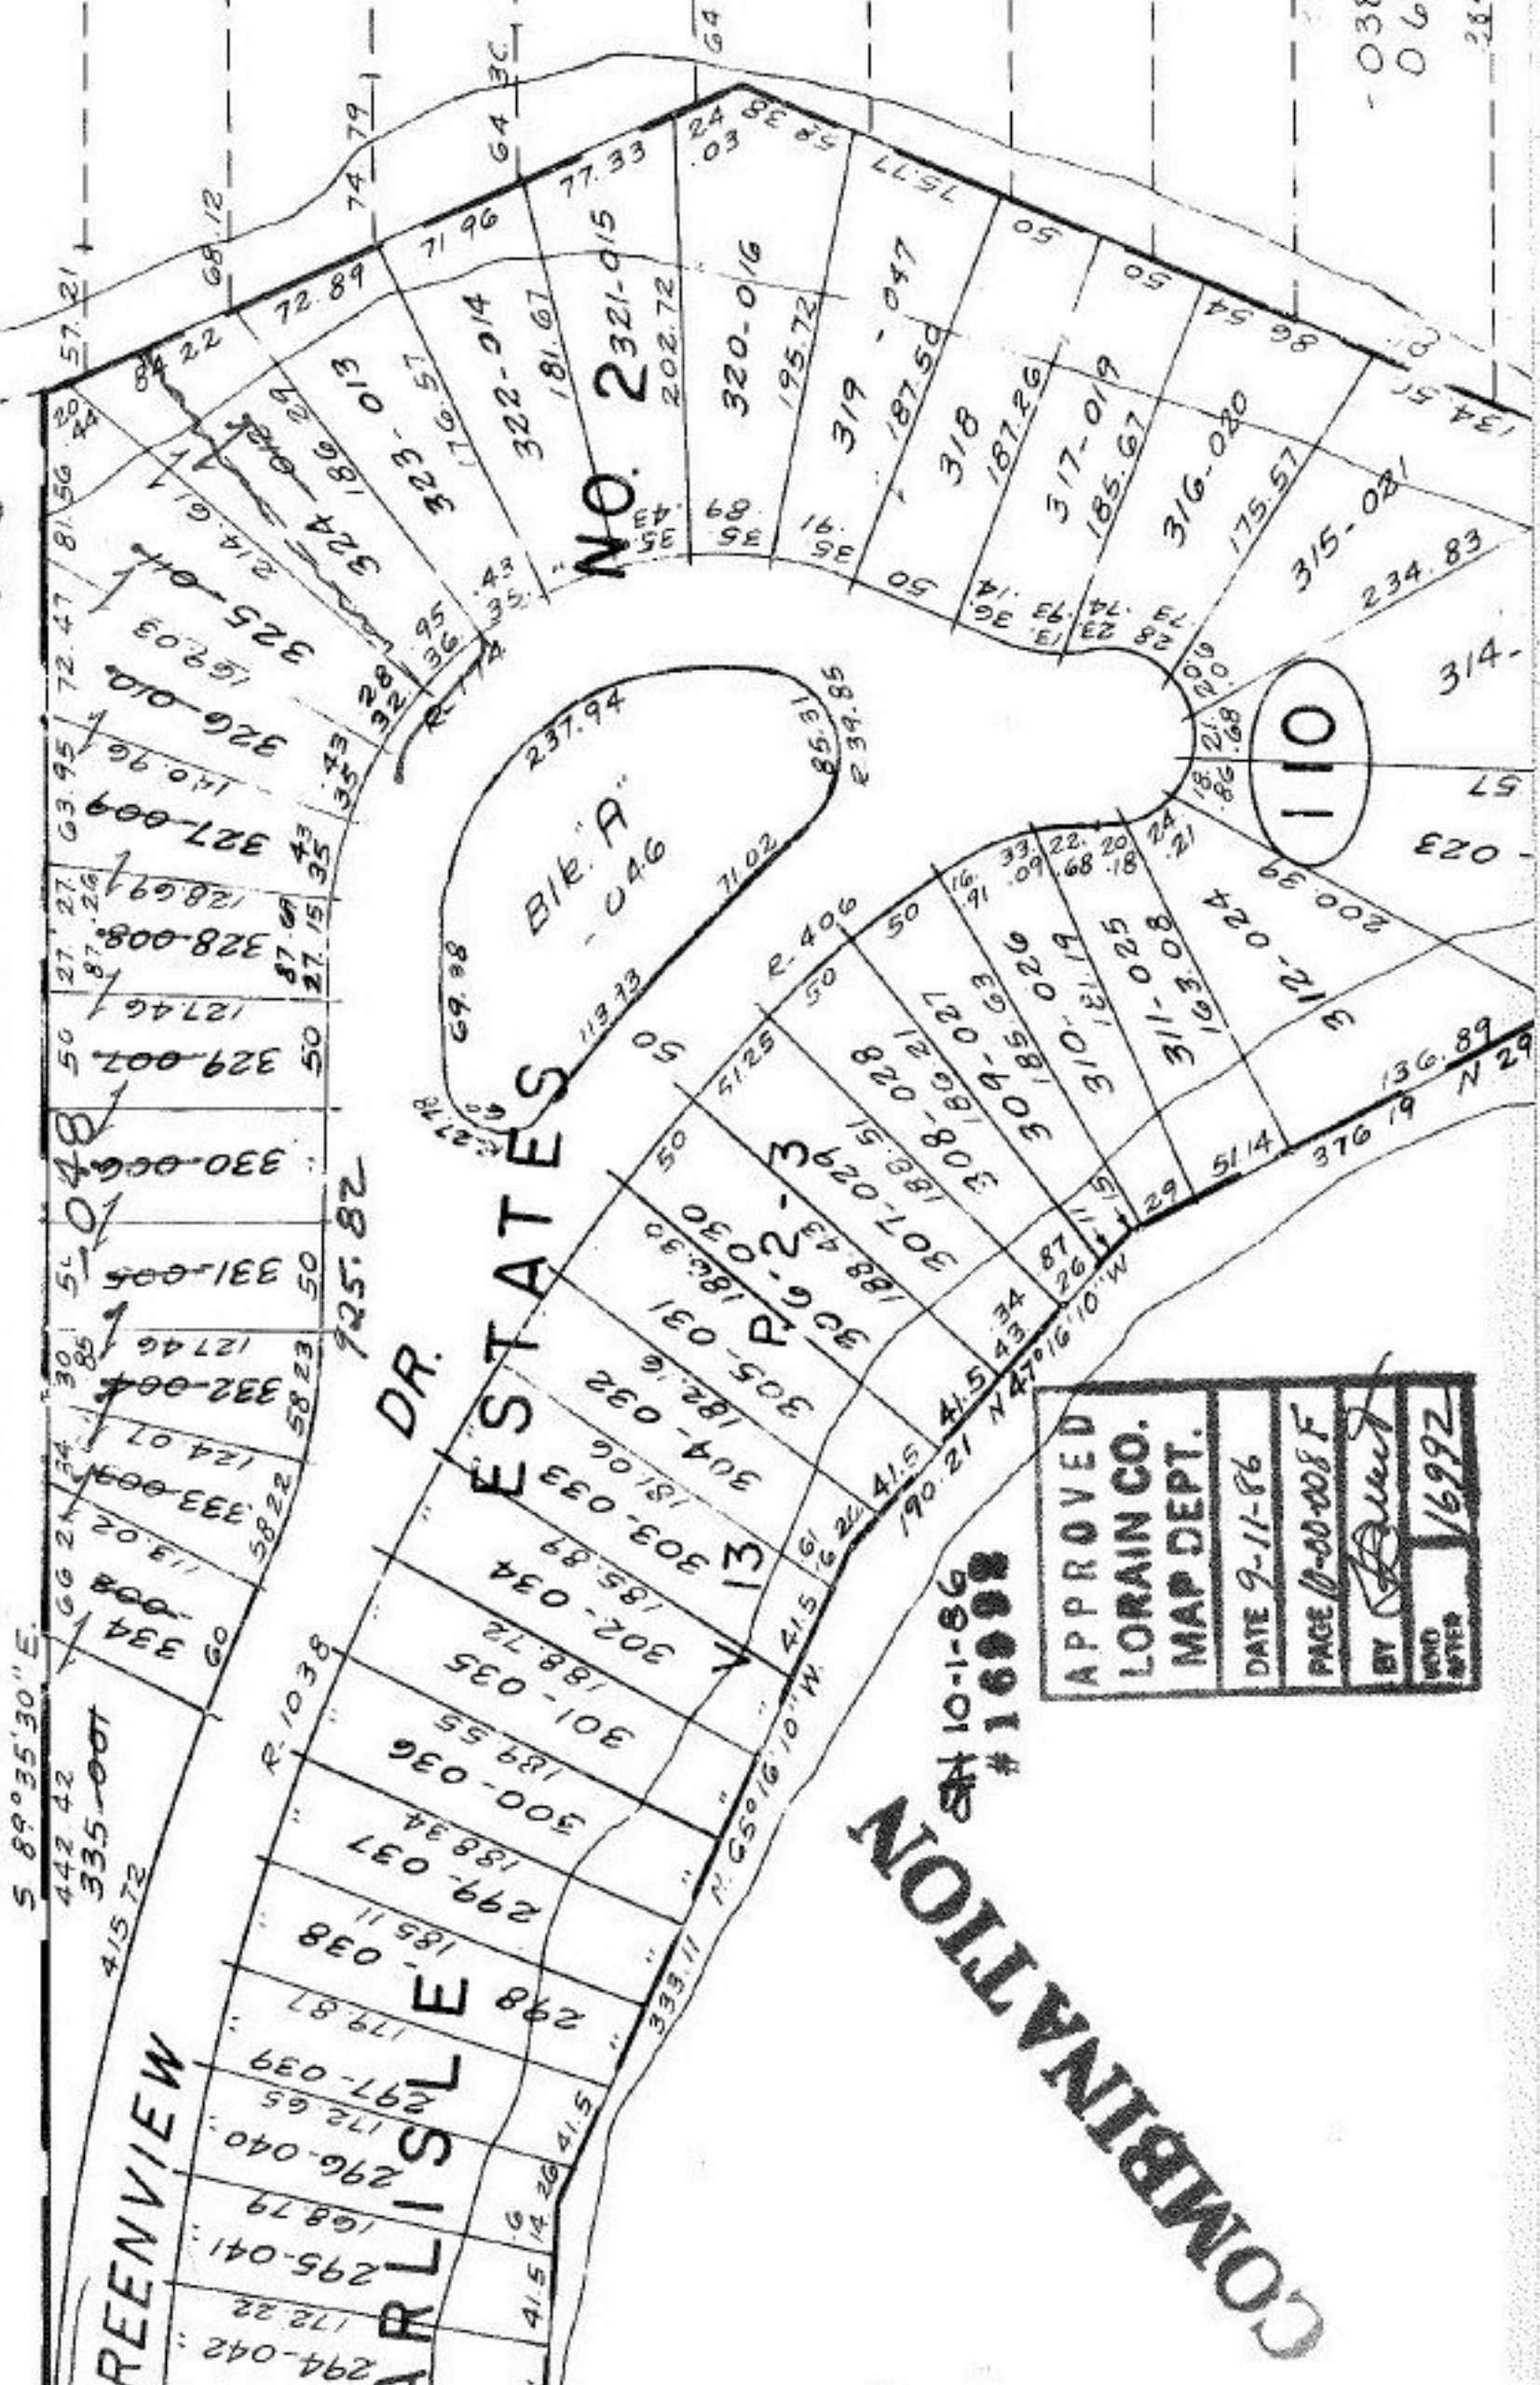

NO. 2321-015

110

APPROVED  
 LORAIN CO.  
 MAP DEPT.  
 DATE 9-11-86  
 PAGE 10-00-008 F  
 BY *[Signature]*  
 WORD AFTER 16992

COMBINATION  
 SH 10-11-86  
 #16992

-038  
-069  
284