


PARENT PARCEL: 02-02-009-101-024

CHILD PARCEL: 02-02-009-101-097, -098

STARTING POINT: INTERSECTION OF C/L OF JAEGER RD, AND EAST LINE OF O.L.9

17-00760

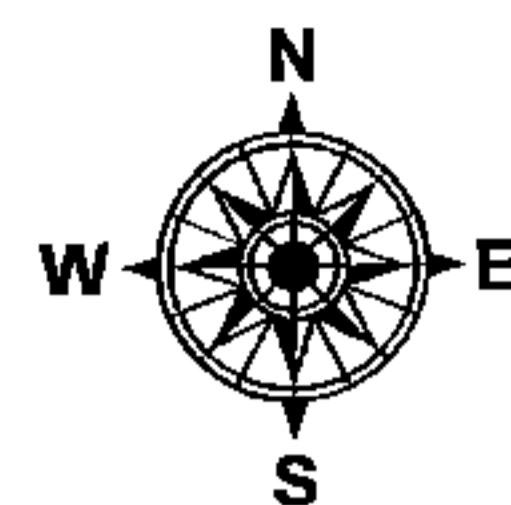

LOR - JAEGER ROAD

58-WD

350.53

-084 .83

-023 .91

-098 .83

~~-024 .91~~

400

366.29

3.35

100

100

100

~~100~~

3.35

225.51

.08

33.21

-083 .08

100

33.21

-097 .08

100

.08

33.21

-060 .17

228.89

33.20

40.24

27.15

200.08

-057 .12

200.08

RD.

27.15

100.01

-042 .06

100.01

49.84

-055 .06

46.74

50

53.09

27.13

-062 .06


100

27.13

JAEGER

-071

200

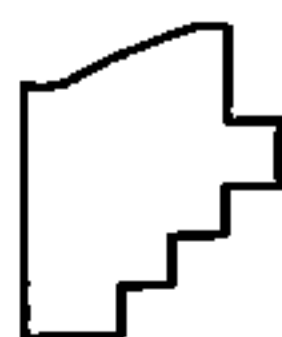

SPLITS/DEEDS PROCESSED

LORAIN COUNTY TAX MAP DEPARTMENT
226 MIDDLE AVE. ELYRIA, OH

SURVEYED BY: TREVOR A. BIXLER

CLOSURE: 1: 2147483648

MAP PAGE(S): 2-02-009

APPROVED BY: RRM DATE: 1-4-18

SCALE: 1" = 75 PRIOR INSTRUMENT: OR 105/448