


Ac. CORR. PER SURVEY
BY CARDINAL SURVEYS

C=1:1000000.

SEE 10-00-015-F

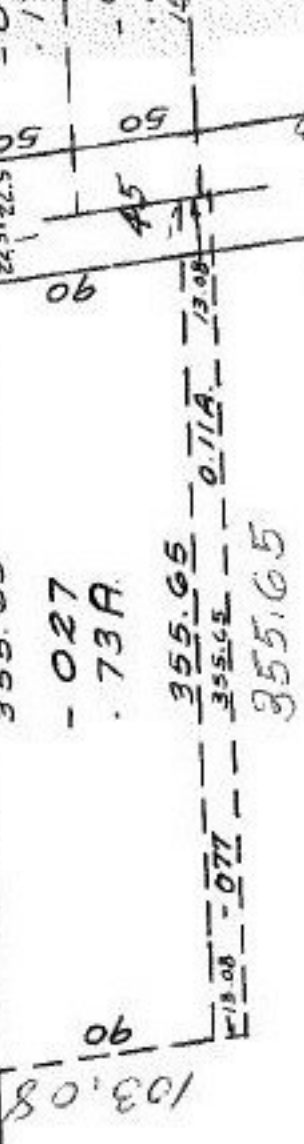

Ac. CORR.
-III
~~3.50A~~
4.73A

~~4.73A~~

-060
4.59 A.

470.68

250.13

255.92

933.59

River

RD.

ROBSON

341.63

238.55

10-1-86
#17001

APPROVED	
IN CHARGE CO.	
MAP DEPT.	
DATE	9-12-86
PAGE	10-02-216-B
BY	F. C. FRANCIS
VOID AFTER	17001