

HAMILTON 614.53

DELETE THIS LINE

SEE 9-00-104-A FOR ADD TO DUP. PARCEL.

REF. 1042/249

ADD TO DUPLICATE SEE SKETCH 112

# 17013


9-30-86

APPROVED
LORAIN CO.
MAP DEPT.
DATE 9-16-86
PAGE 9-00-104
BY T. McNeil
VOID AFTER
-022

25.08

2/2

IN THIS ANNEXATION BERLIN IS ONLY A PART OF - 022.

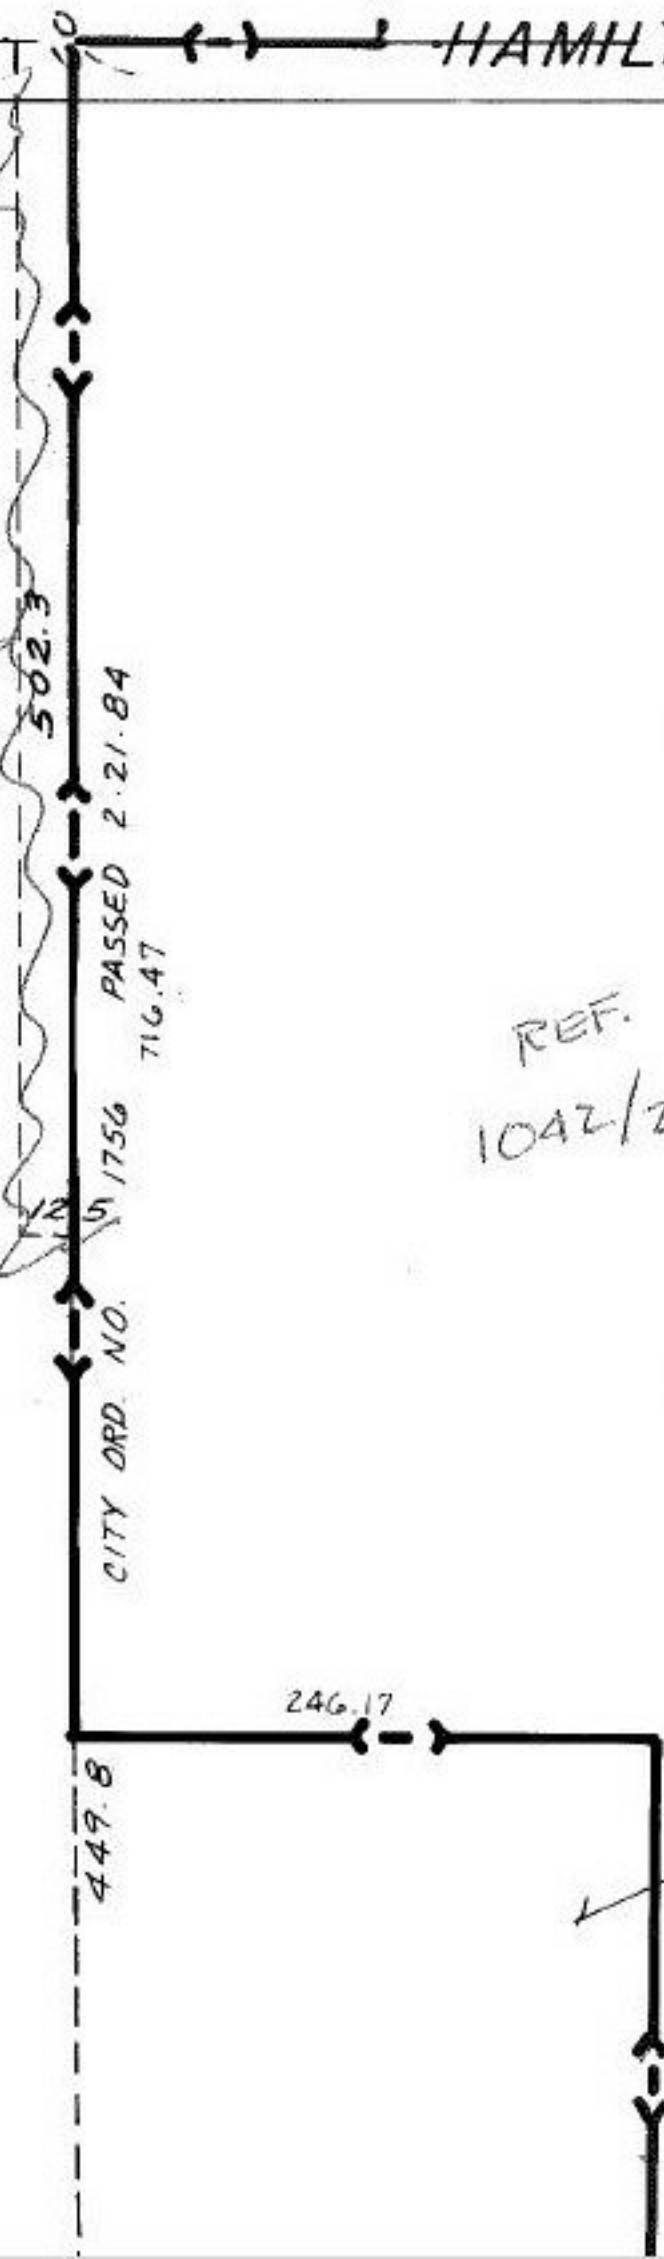

04-A

2