


5-29-87 EB

SEE 4-E

1702

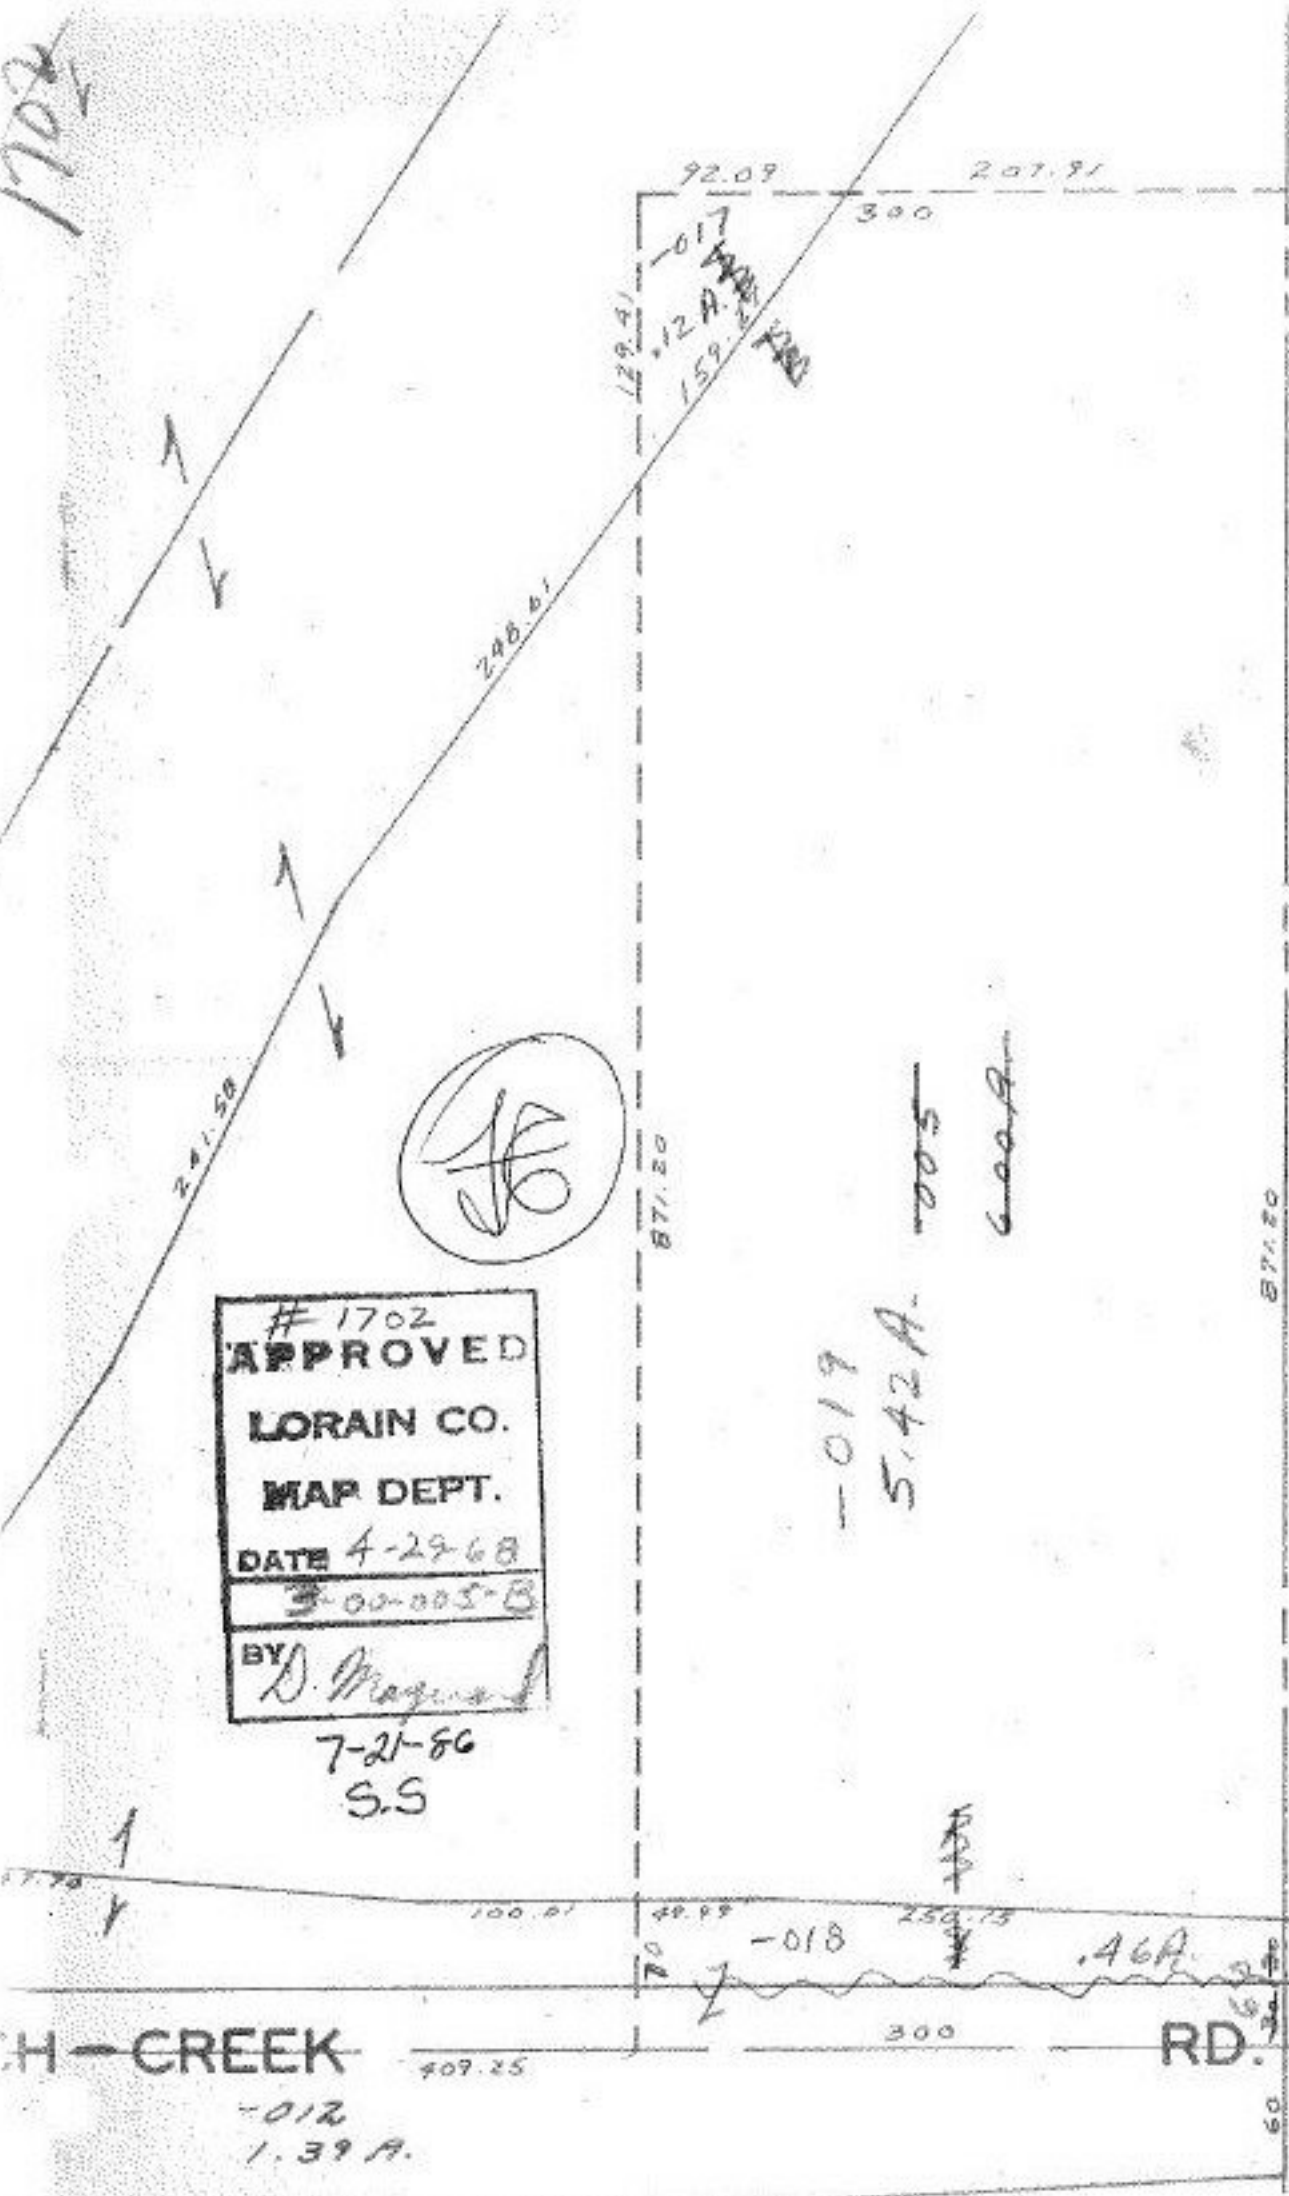

# 1702  
**APPROVED**  
 LORAIN CO.  
 MAP DEPT.  
 DATE 4-29-68  
 3-00-005-B  
 BY *D. Magwood*

7-21-86  
S.S.

-019  
 5.42 A.  
 005  
 600 A.

CREEK

RD.

-012  
 1.39 A.  
 836.37

Done 7-6-68 LWHall