


10-00-004-113
 Prior Deed 1000-536
 Surveyed BY K.S.A

C=1:22727 P-1
 C=1: INF P-2
 C=1: INF P-3

SEE 10-00-003-H

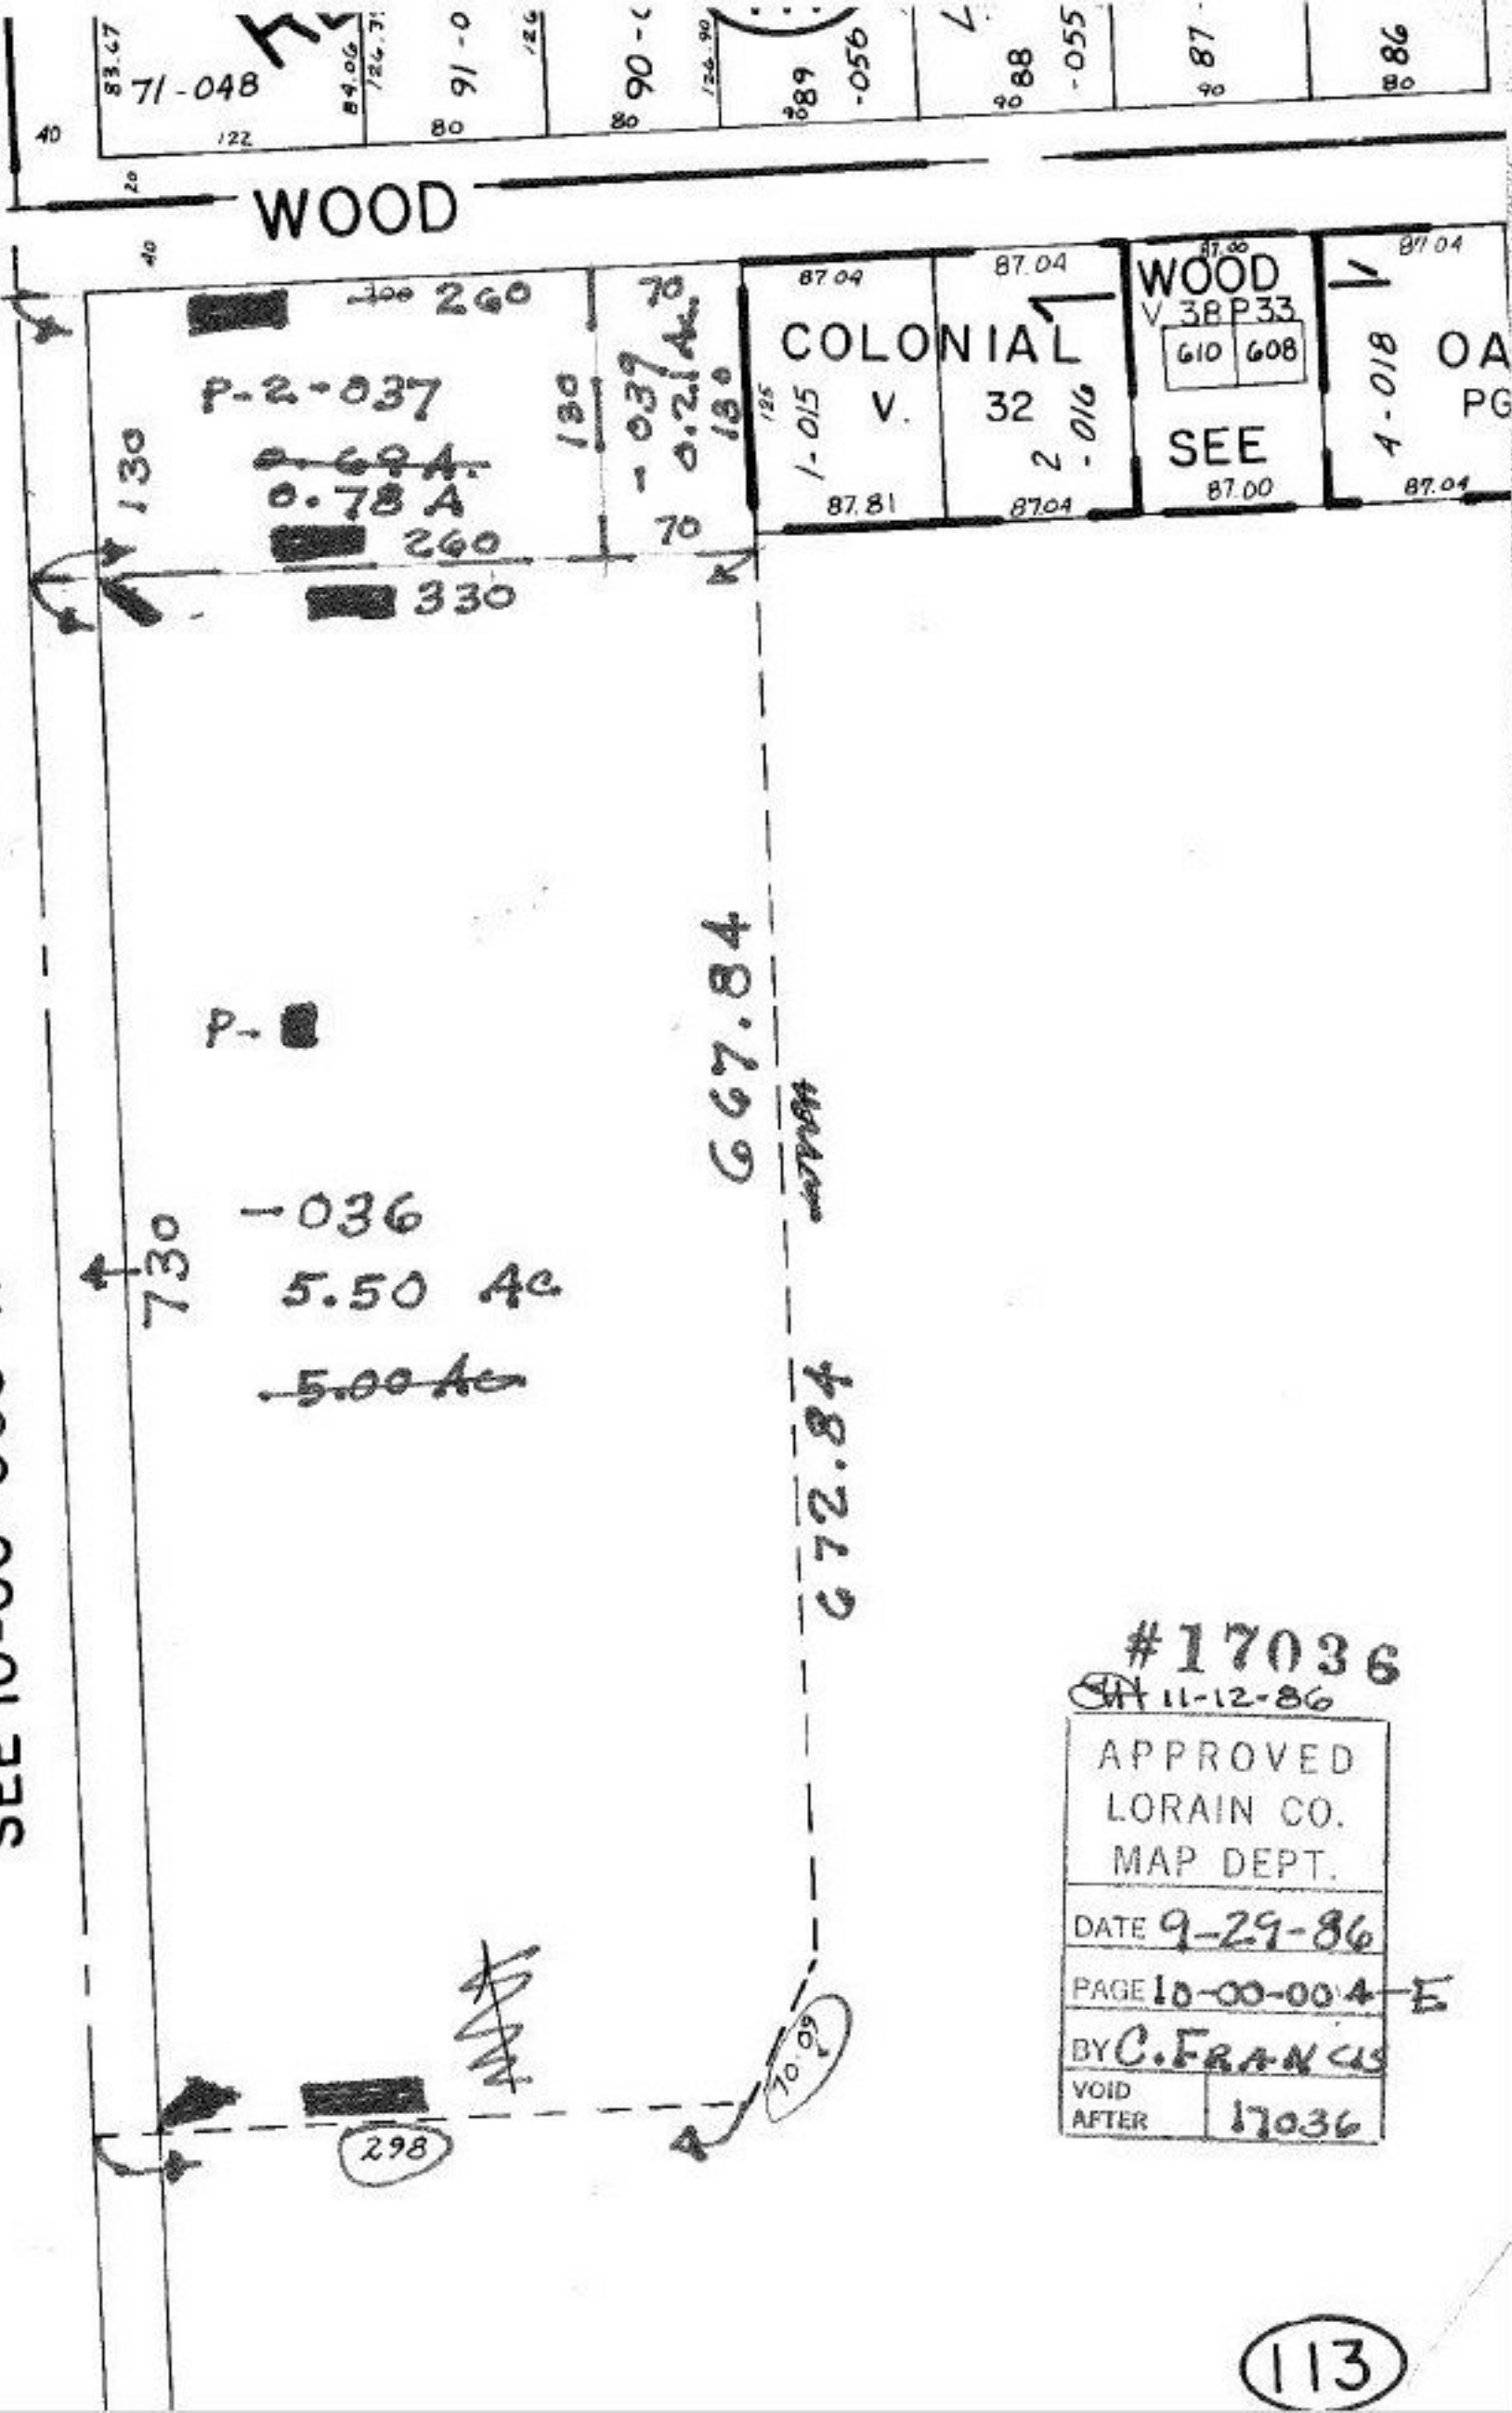

#17036
 11-12-86

APPROVED LORAIN CO. MAP DEPT.	
DATE 9-29-86	
PAGE 10-00-004-E	
BY C. FRANCIS	
VOID AFTER	17036