


05-00-004-106  
 PRIOR DEED 923-169

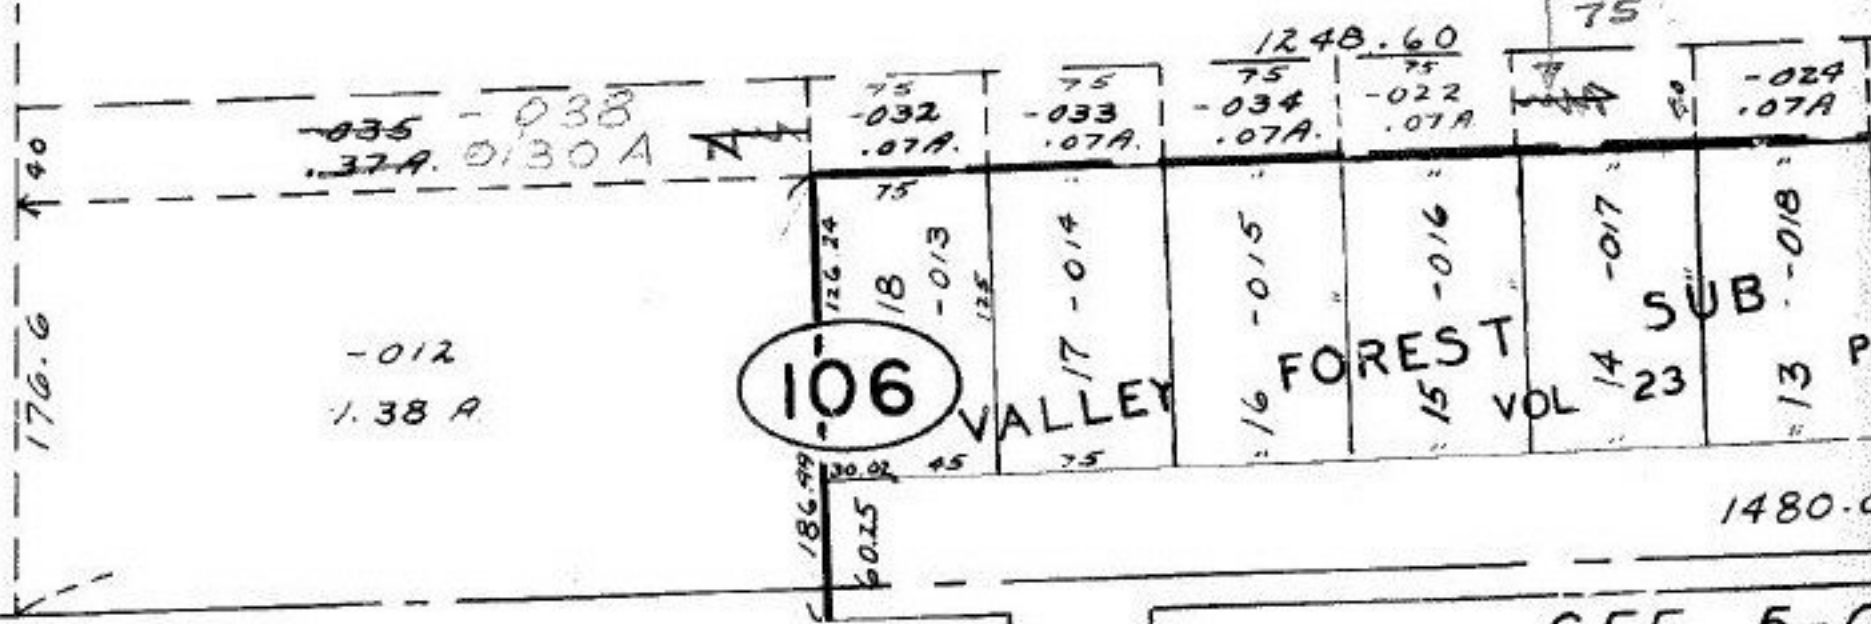

# AMHERST TWP

SCALE: 1" = 100'

SEE 5-C

SA 10/2/86  
 #17049

APPROVED	
LORAIN CO.	
MAP DEPT.	
DATE	10-2-86
PAGE	5-00-004-B
BY	C. Francis
VOID AFTER	17049

#17049