


6-2-87 OK

#1706
APPROVED
LORAIN CO.
MAP DEPT.
 DATE 6-29-68
 BY *[Signature]*

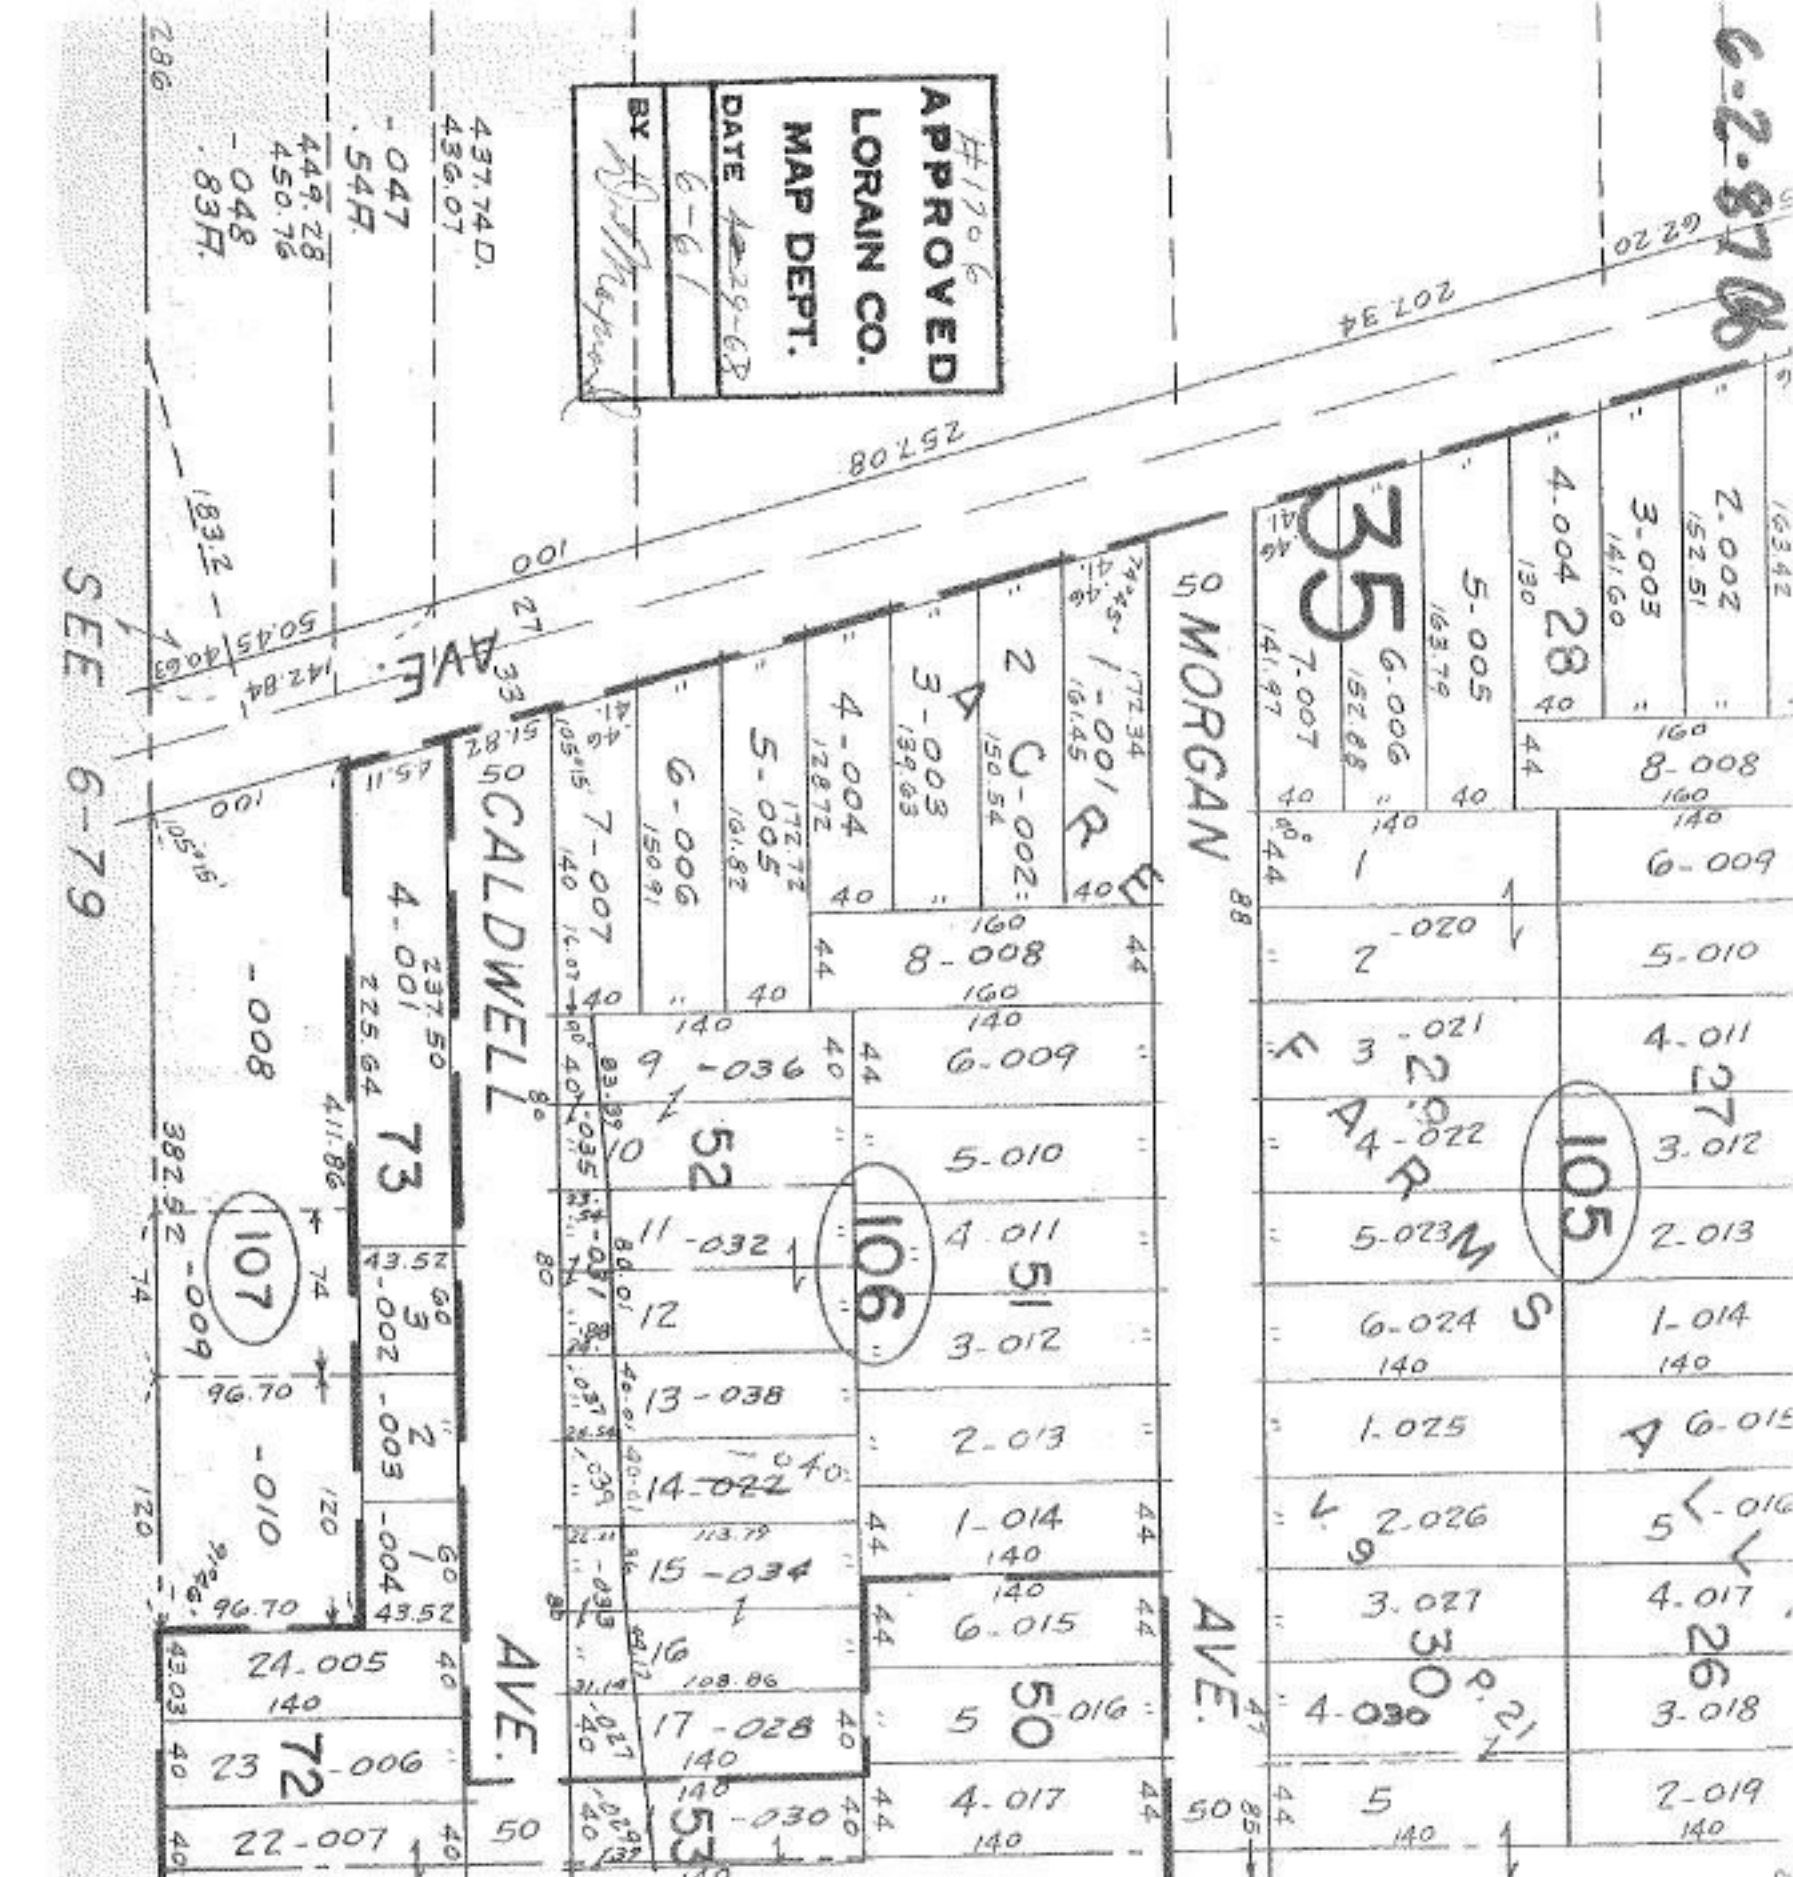

ACRE FARMS ALLT. 2

V. II. P. 29

[Handwritten signature]

Done 6-1-68
L W Hall

1706

SEE 6-79

AVF

CALDWELL

AVE.

MORGAN

AVE.

105

106

107

73

72

71

0

