


SEE 5-00-083

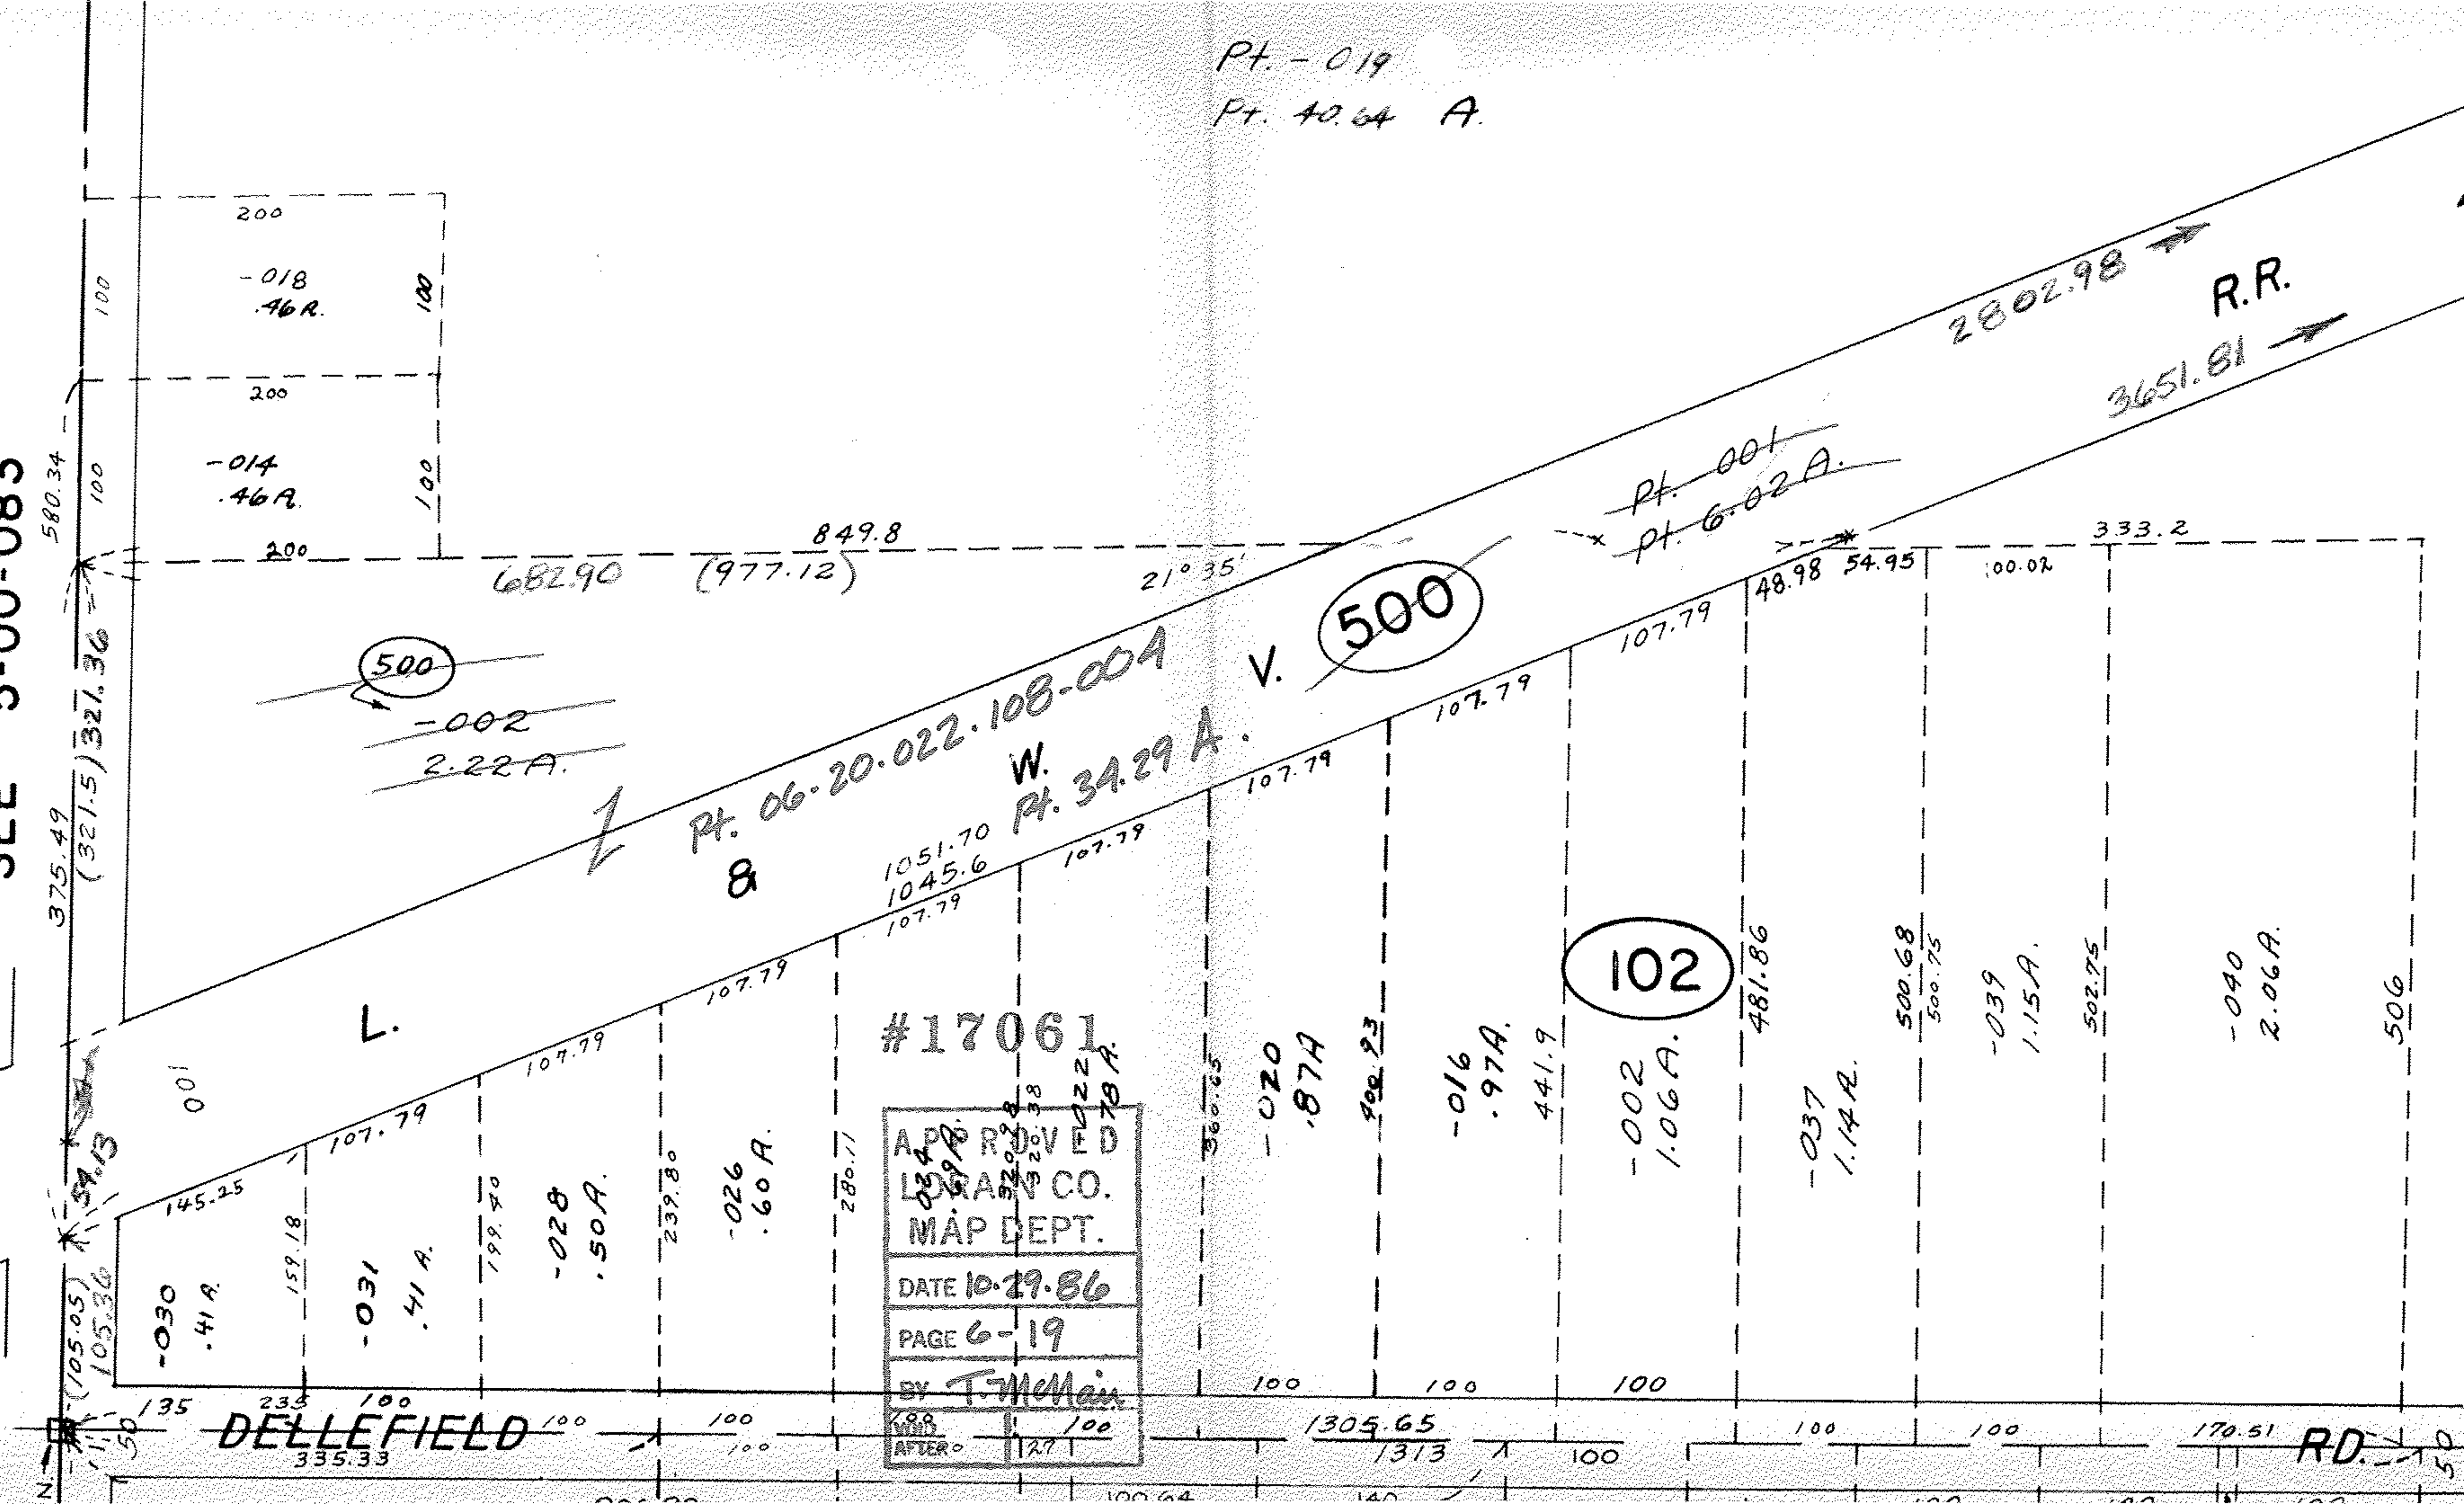

#17061

APPROVED  
LORAIN CO.  
MAP DEPT.

DATE 10-29-86

PAGE 6-19

BY T. McMan

100  
AFTER 27

11-12-86  
T.M

#17061

APPROVED  
LORAIN CO.  
MAP DEPT.

DATE 10-30-86

PAGE 6-19

BY T. McMan

VOID  
AFTER