

43.12 A.


1075

150
540 -007
2.00 R.
590

2 MON. 570.32

187.50
549.67
82.50
470.93

U -005
T 1.66 A.
547.72

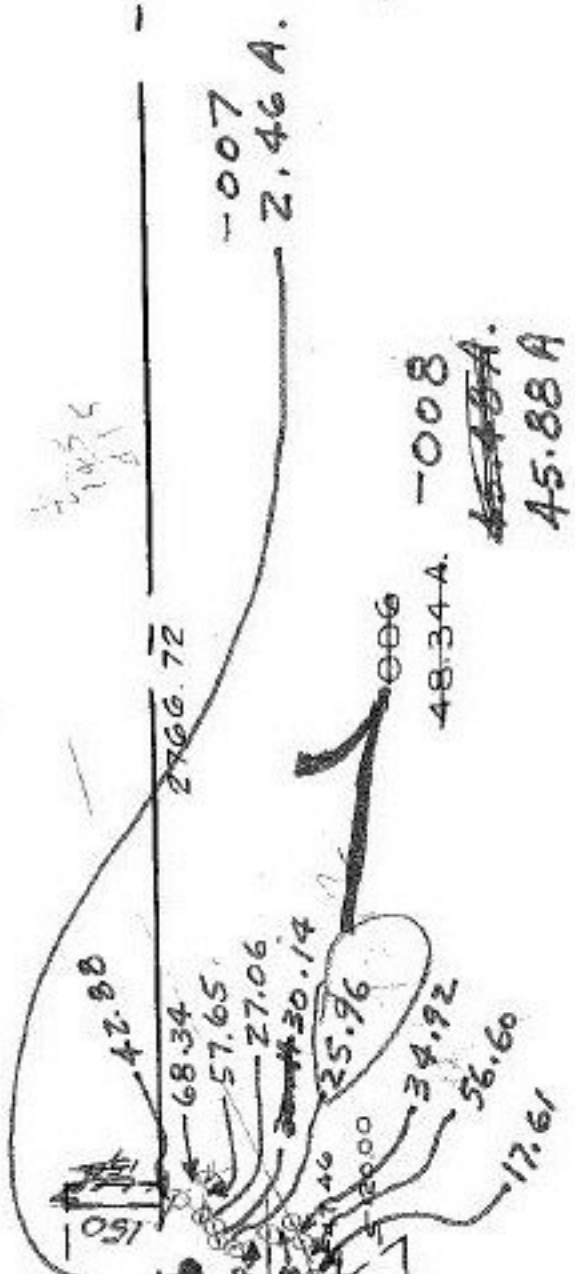

-007
2.46 A.

-008
~~45.88 A.~~
45.88 A

006
48.34 A.

62

-002
93.50 A.

48.34 A.
25.96
34.92

-003 80
1.00 R.
220

330
-005 80
2.50 R.

330

95
208
20 R.

395

89974
1083 20

MON.

-001

-001
47.44 A.

245

10/21/86

#17072

APPROVED LORAIN CO. MAP DEPT.	
DATE 10-15-86	
PAGE 9-E	
BY <i>[Signature]</i>	
VOID AFTER	17072

-006
29.28 A.

-004
21.25 R.

990
-003 138 R.
1000 56

957

957

179057

320