



SEE 3-00-10

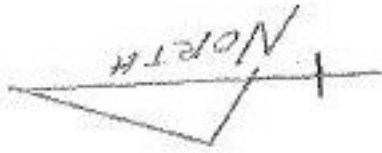

101

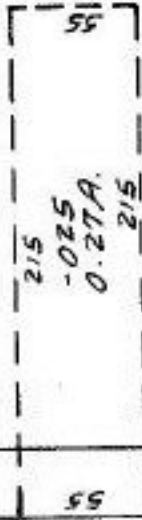


852.67

361.23

~~003~~
~~707A~~

-030
6.65 A.

SEE SURVEY
KSA CL. 1:1NF.

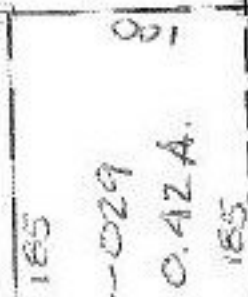

~~852.67~~ 667.67

-027
3.47 A.

177.18

852.67

APR 11-12-86
#17091

APPROVED
LORAIN CO.
MAP DEPT.
DATE 10-29-86
PAGE 3-00-104 A
BY T. McMain
VOID AFTER

361.23 261.23

100

177.18

-029