


SEE 4-00-019-F

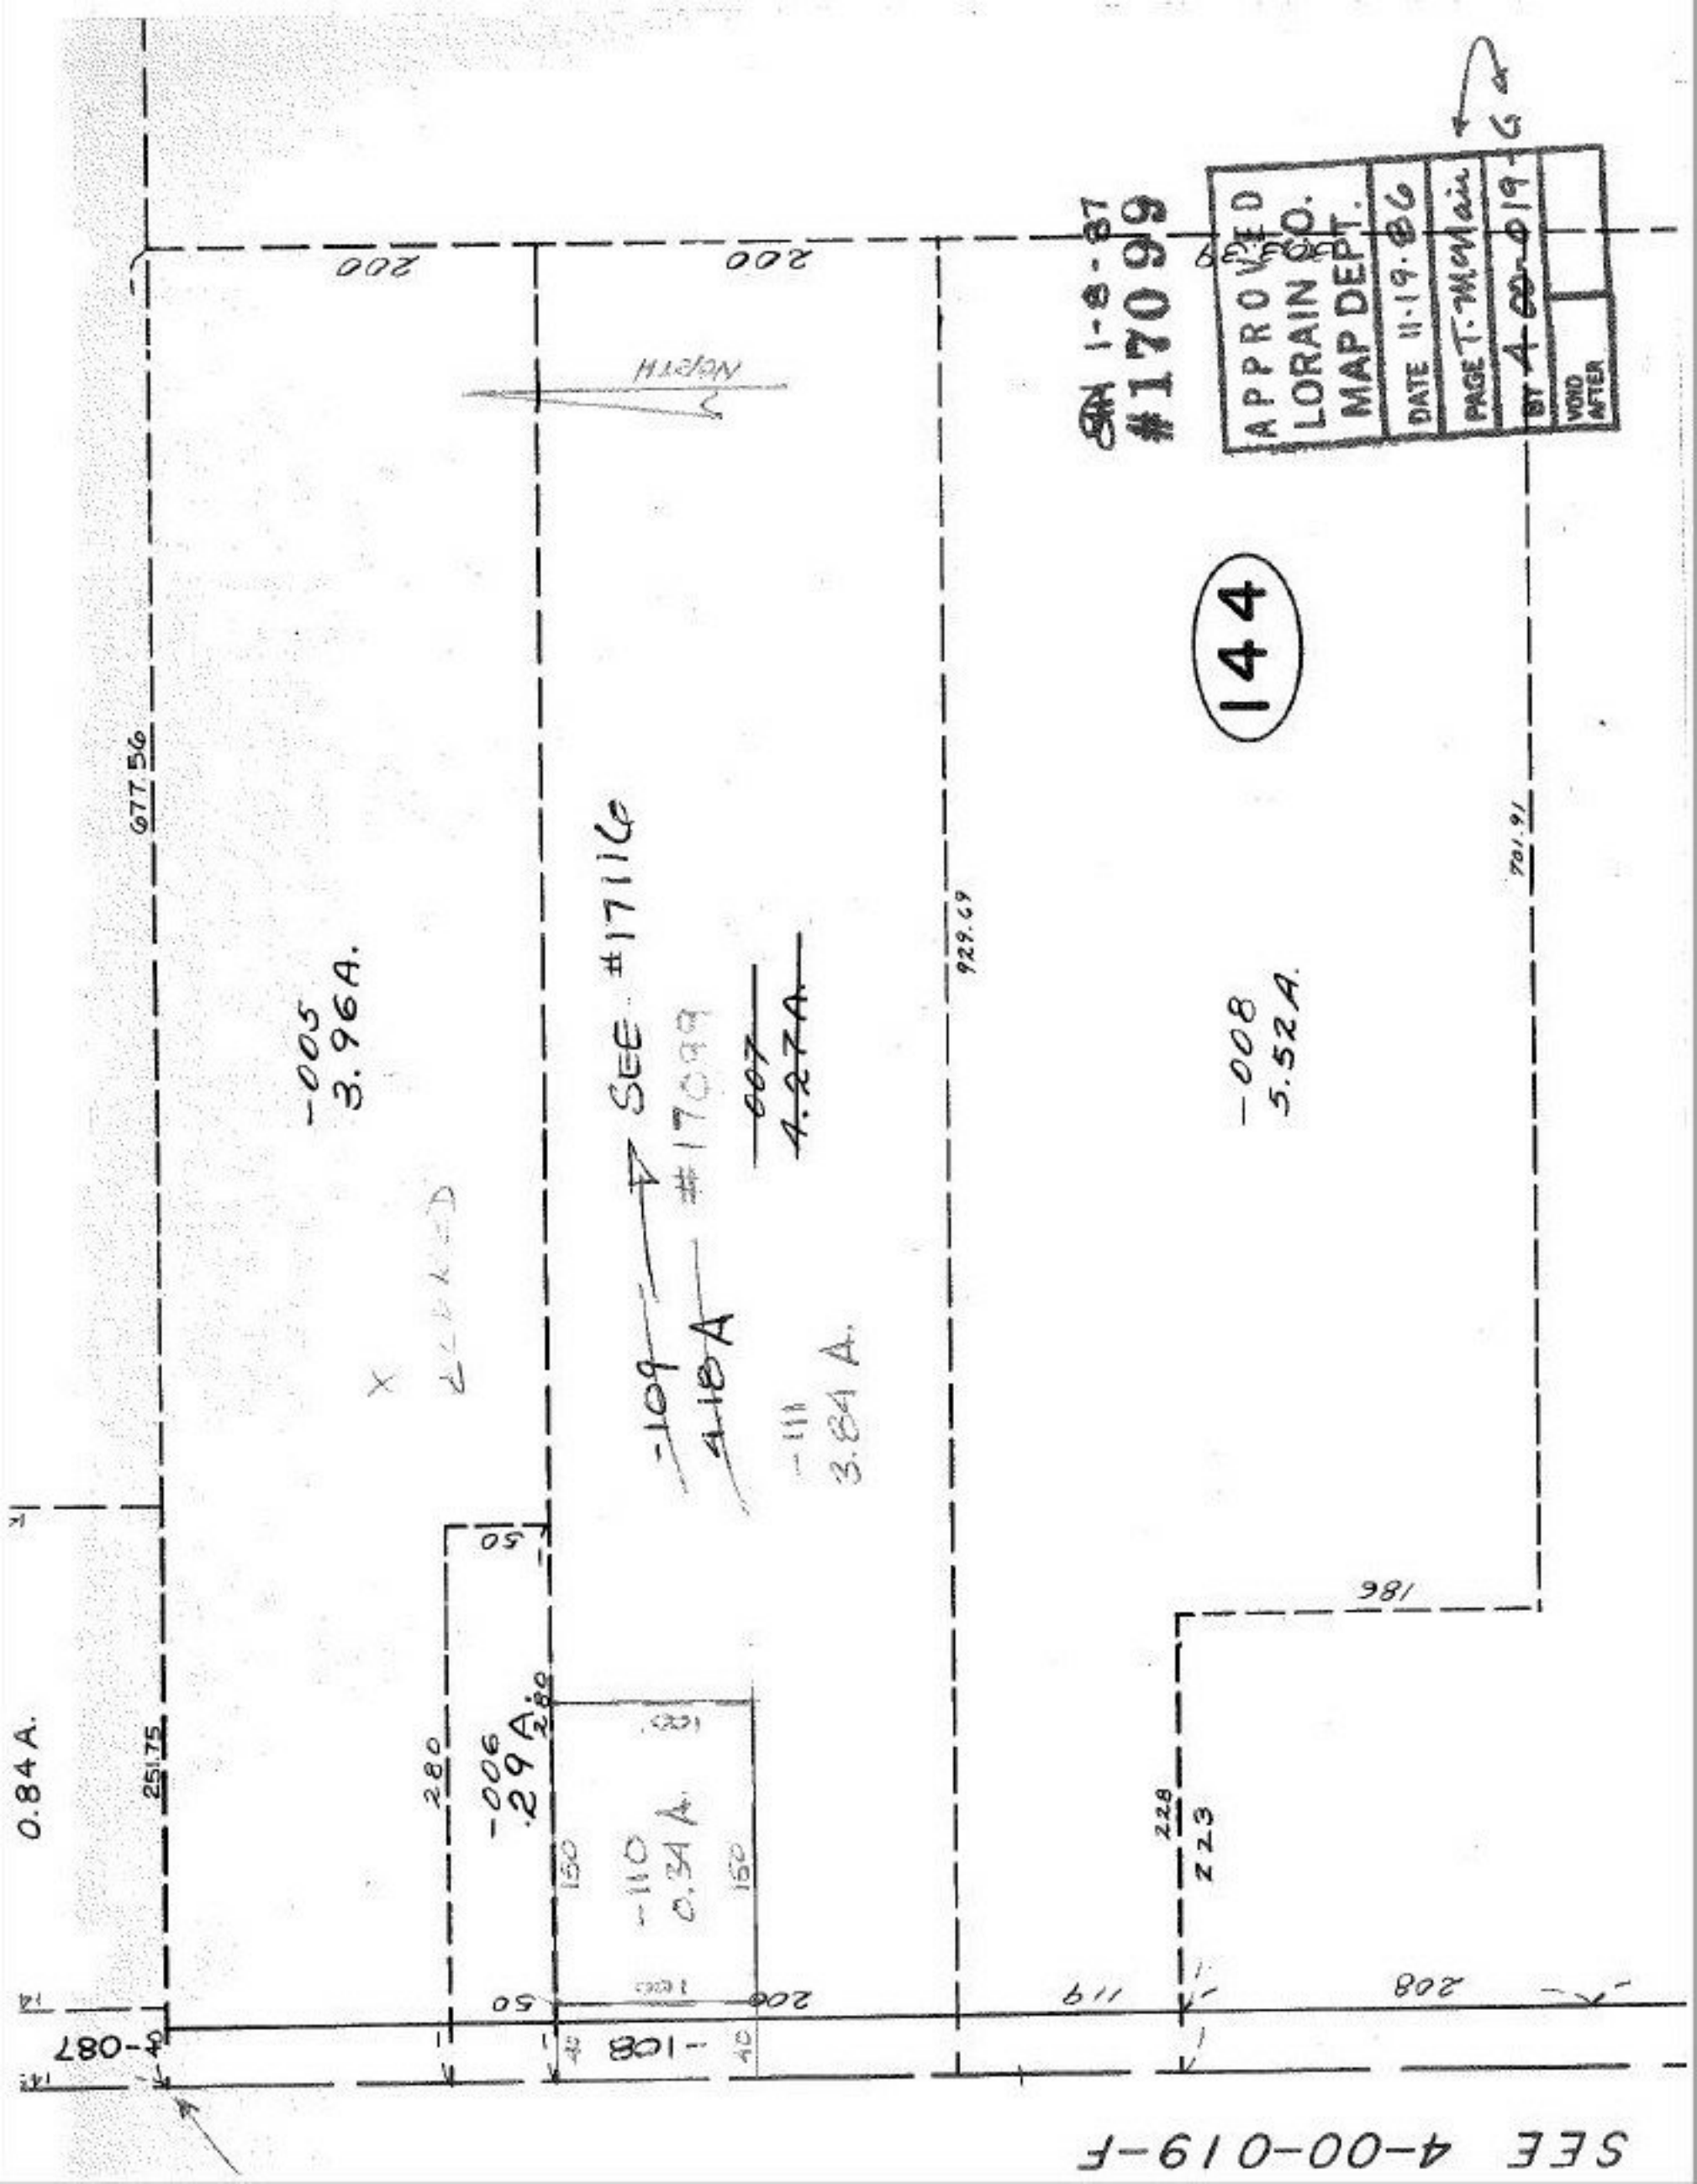

144

APPROVED
LORAIN CO.
MAP DEPT.
DATE 11-19-86
PAGE T. McMain
BY 4-00-019-G
VOID AFTER

SN 1-8-87
#17099

-008
5.52 A.

SEE #17116

~~109~~ →
~~418 A~~ #17099

~~007~~
~~4.27 A.~~

-111
3.84 A.

-005
3.96 A.

X
L.L.K.D.

-006
0.29 A.

-110
0.34 A.

0.84 A.

677.56

251.75

280

50

150

150

150

929.69

701.91

186

228


223

119

208

200

200

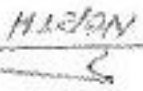

0-087