


SEE 12-00-024-A

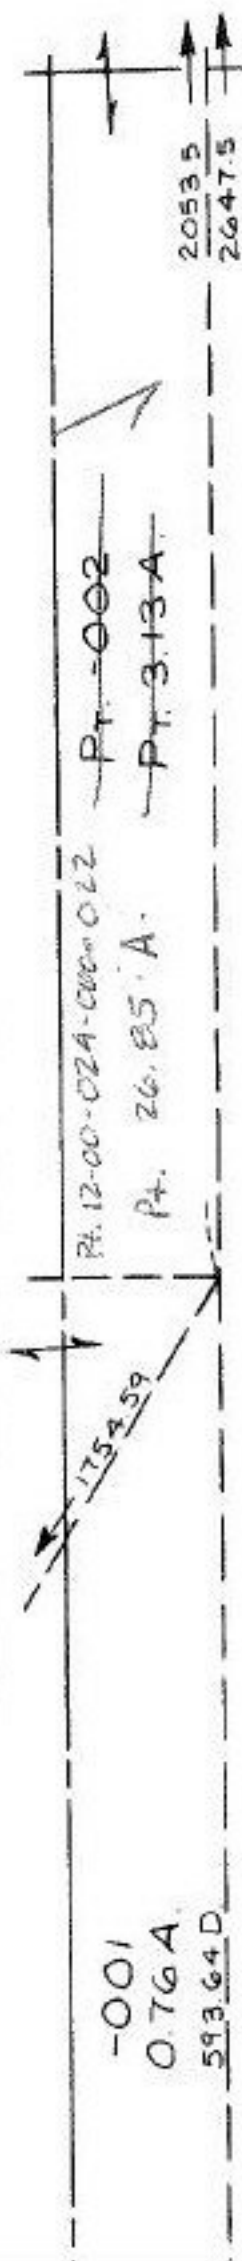

Pt. -003  
Pt. 10.00A.

1323.68

Pt. -049  
Pt. 5.00A.

1323.86

Pt. -006  
Pt. 10.00A.

12-1-86  
COMBINATION  
#17105

APPROVED
LORAIN CO. MAP DEPT.
DATE 11-24-86
PAID 12-00-025-
BY T. McMain
VOID AFTER

A