


6-1-87 *WR*

DONE 7/8/68 W. Koehls

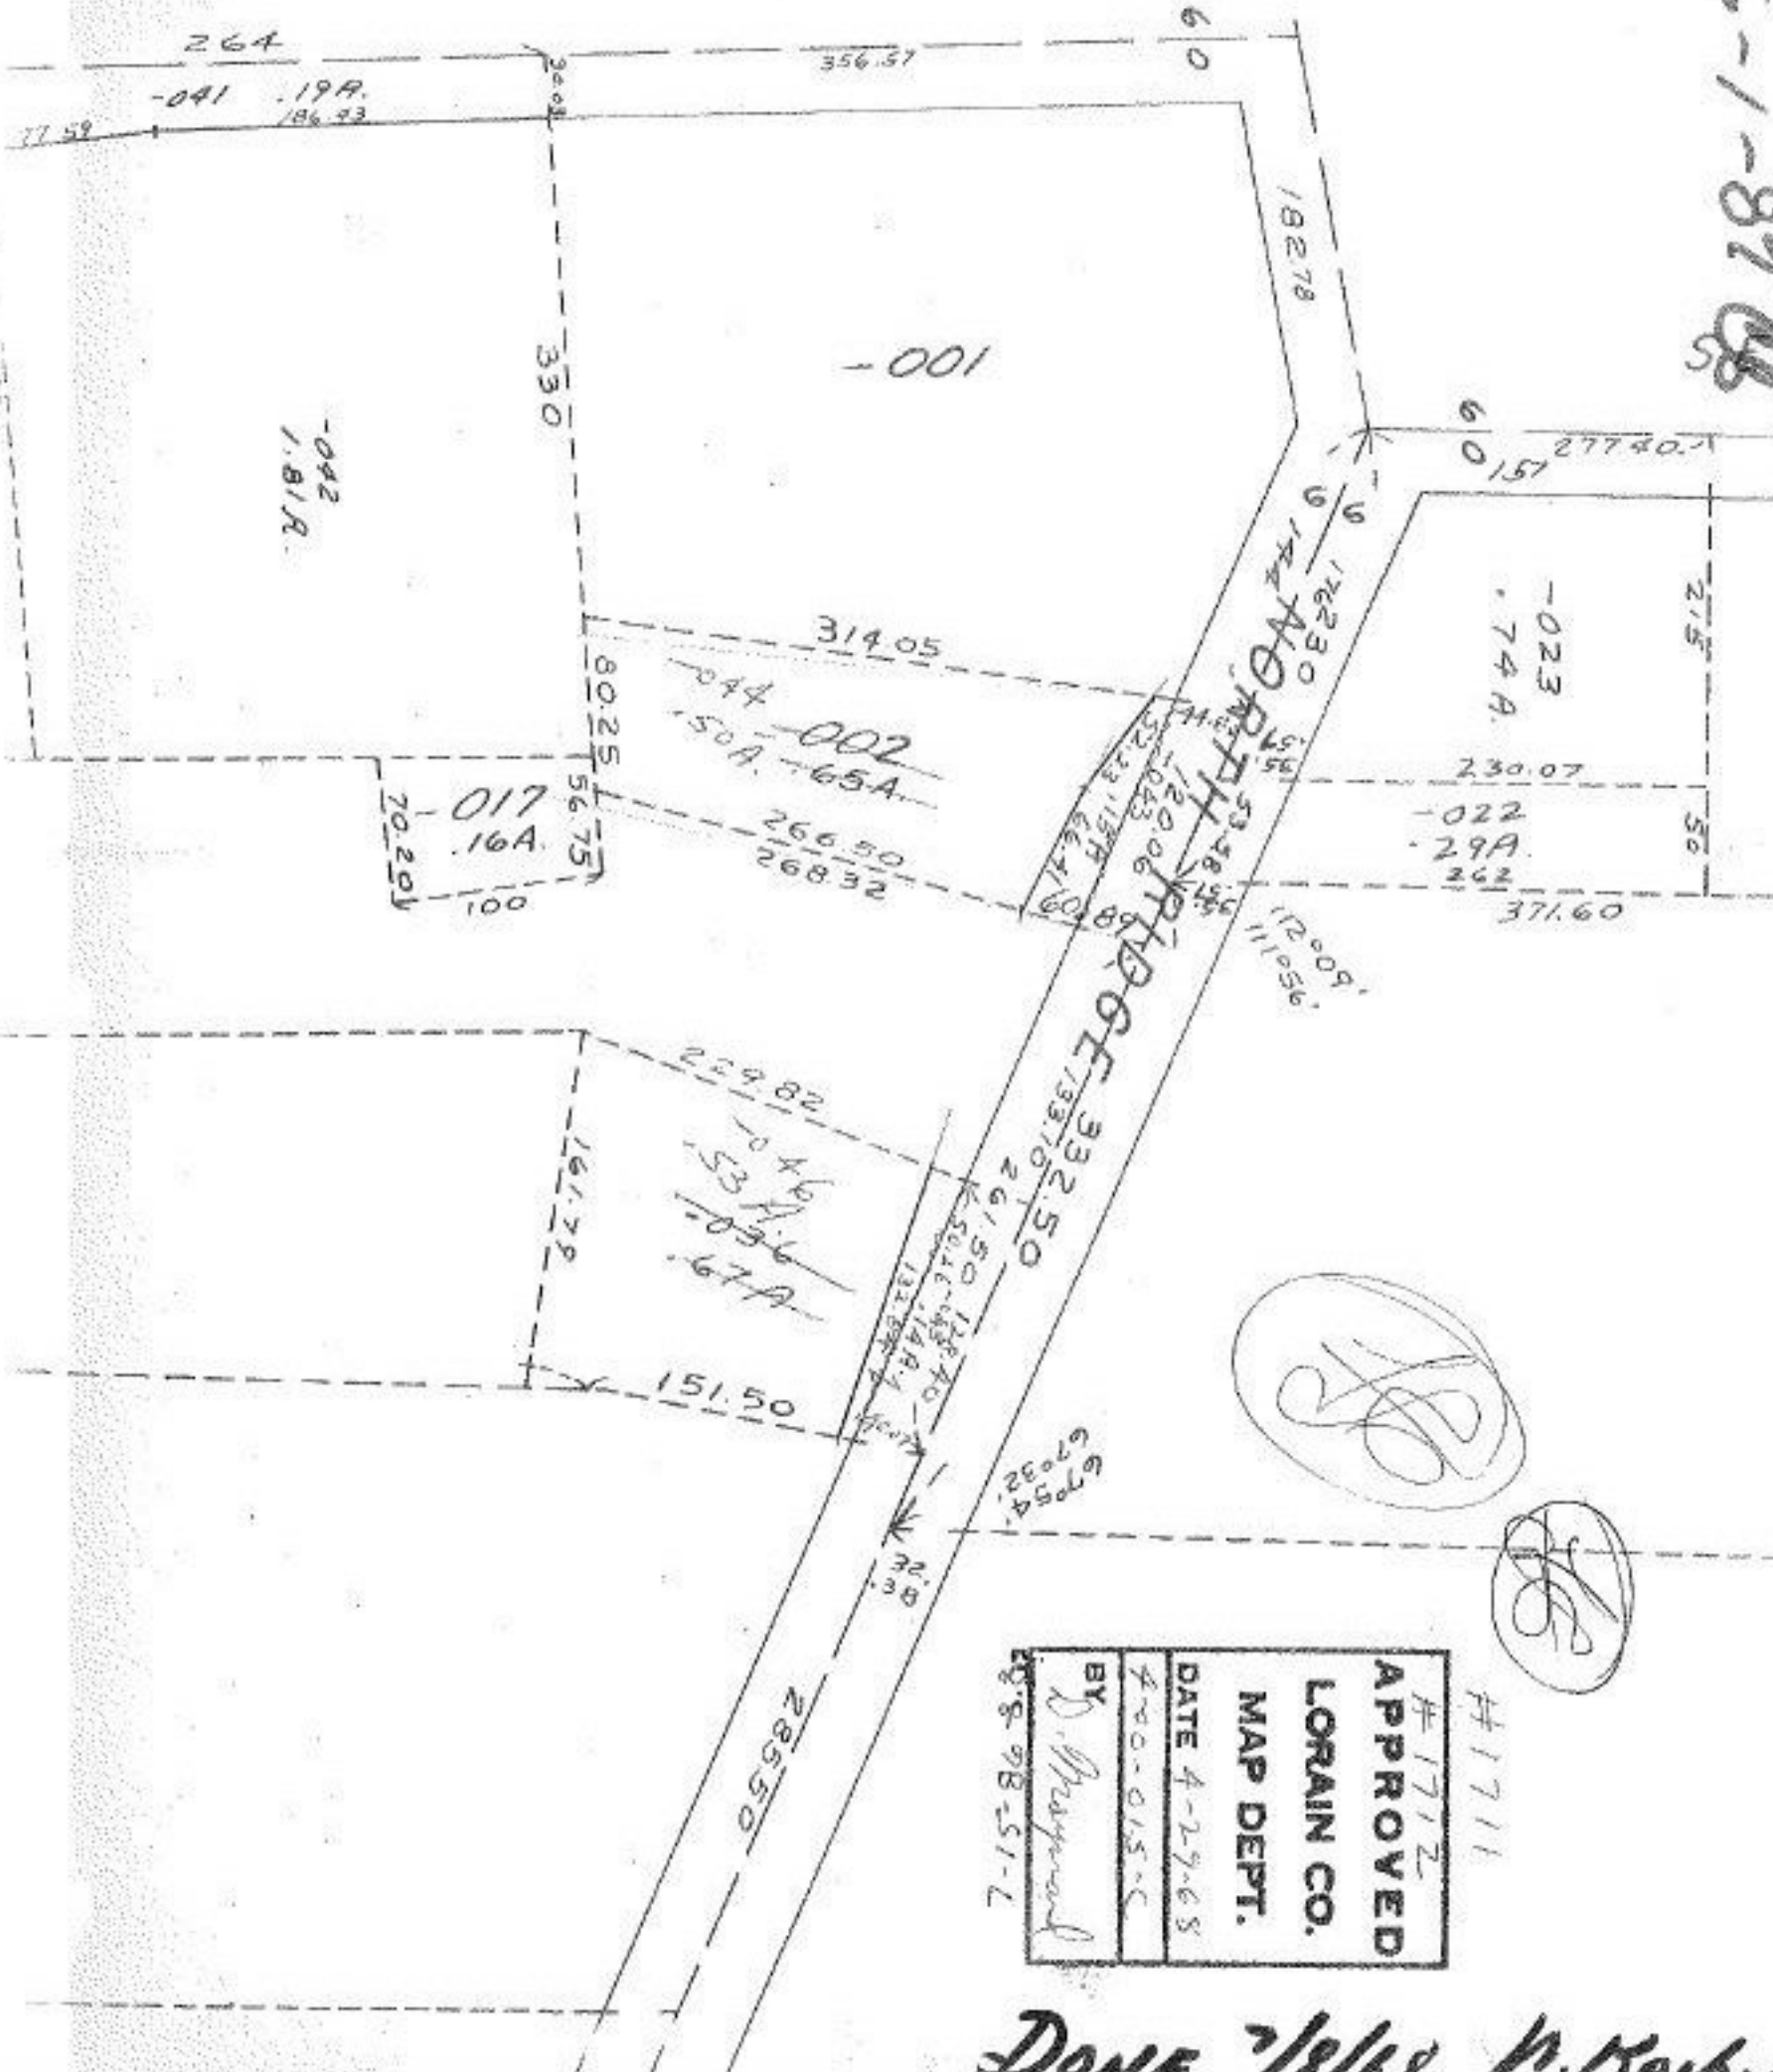

#1711
 #1712
APPROVED
LORAIN CO.
MAP DEPT.
 DATE 4-29-68
 BY *D. Propp*
 67054
 67032
 208-98-51-7

DONE 7/8/68 W. Koehls