


BROAD


SMPSELL & SNEHRER'S

AV. V2 P65

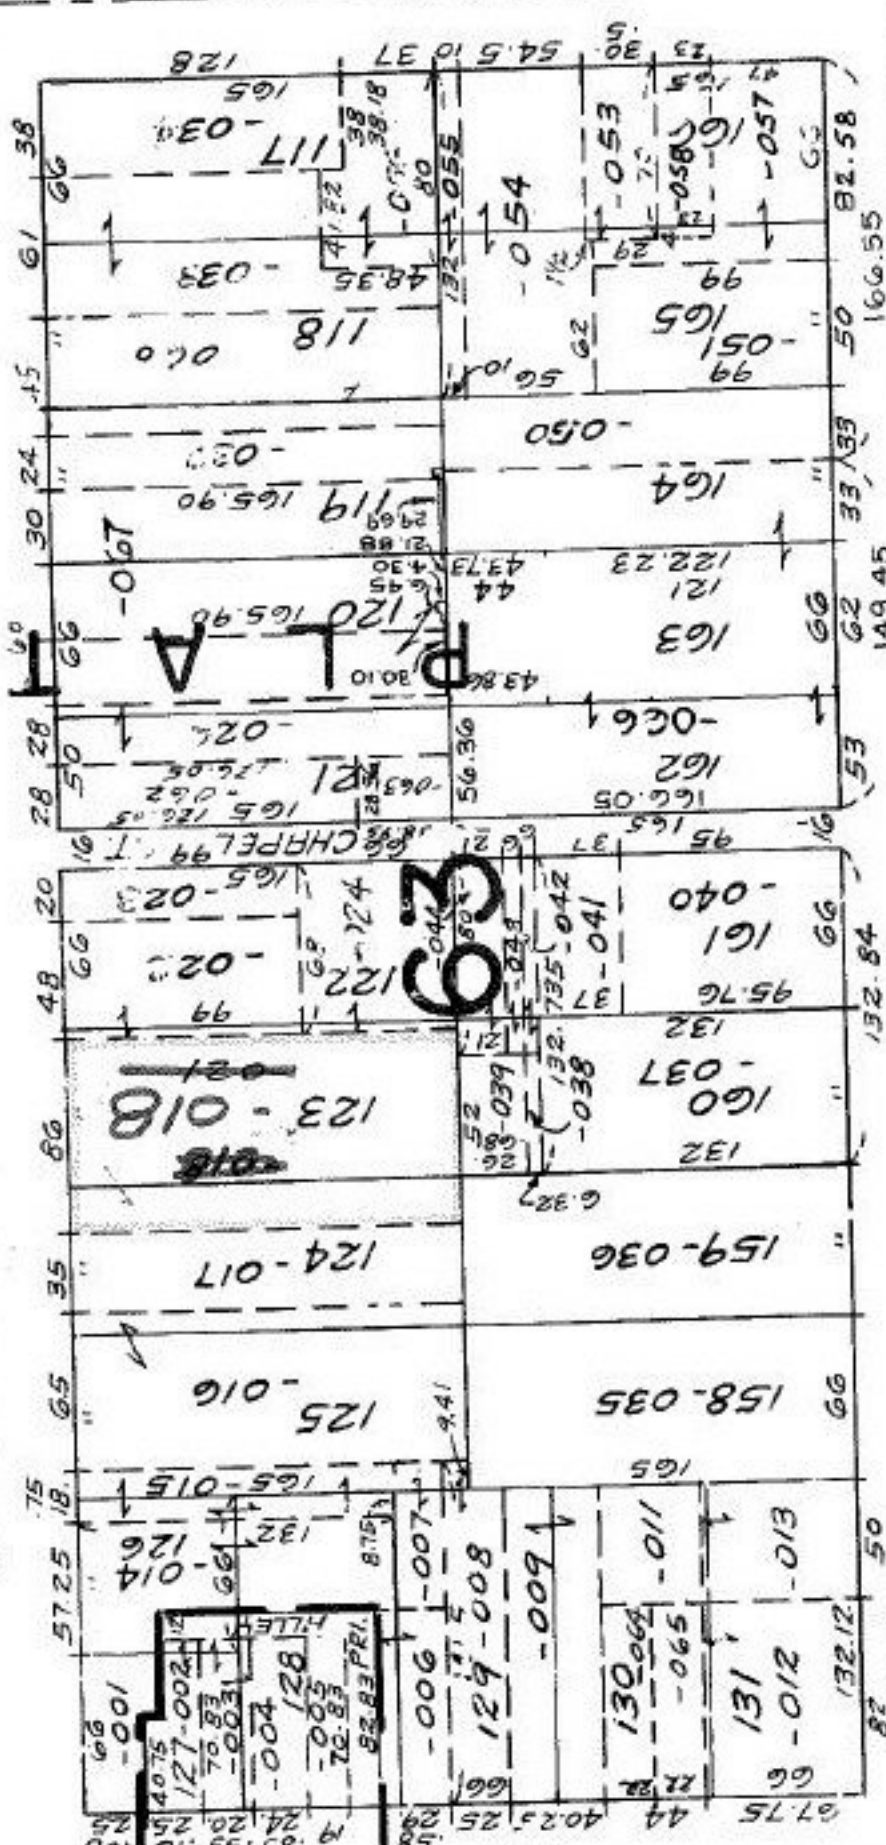

2nd.

TEMPLE

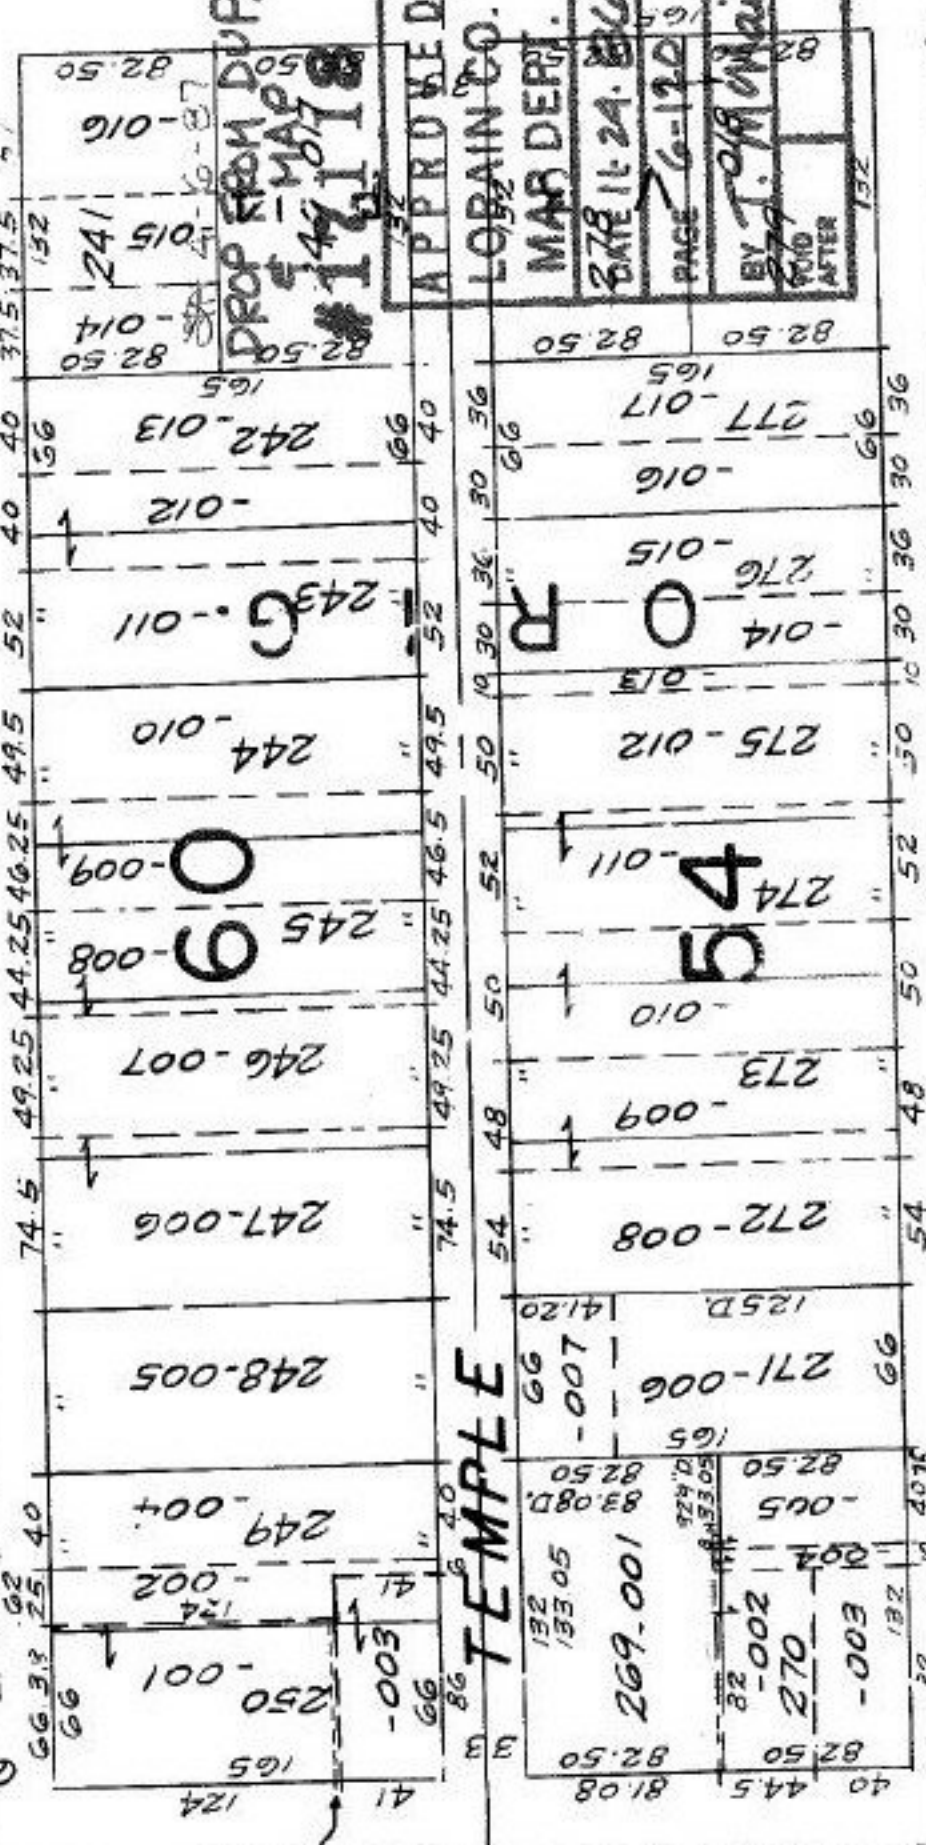

APPROVED
 LOBRAIN CO.
 MAP DEPT.
 DATE 11-24-1916
 PAGE 6-120
 BY T. J. Main
 1916

-018
1.15 x 66