


RD.



SEE 11-00-071-B

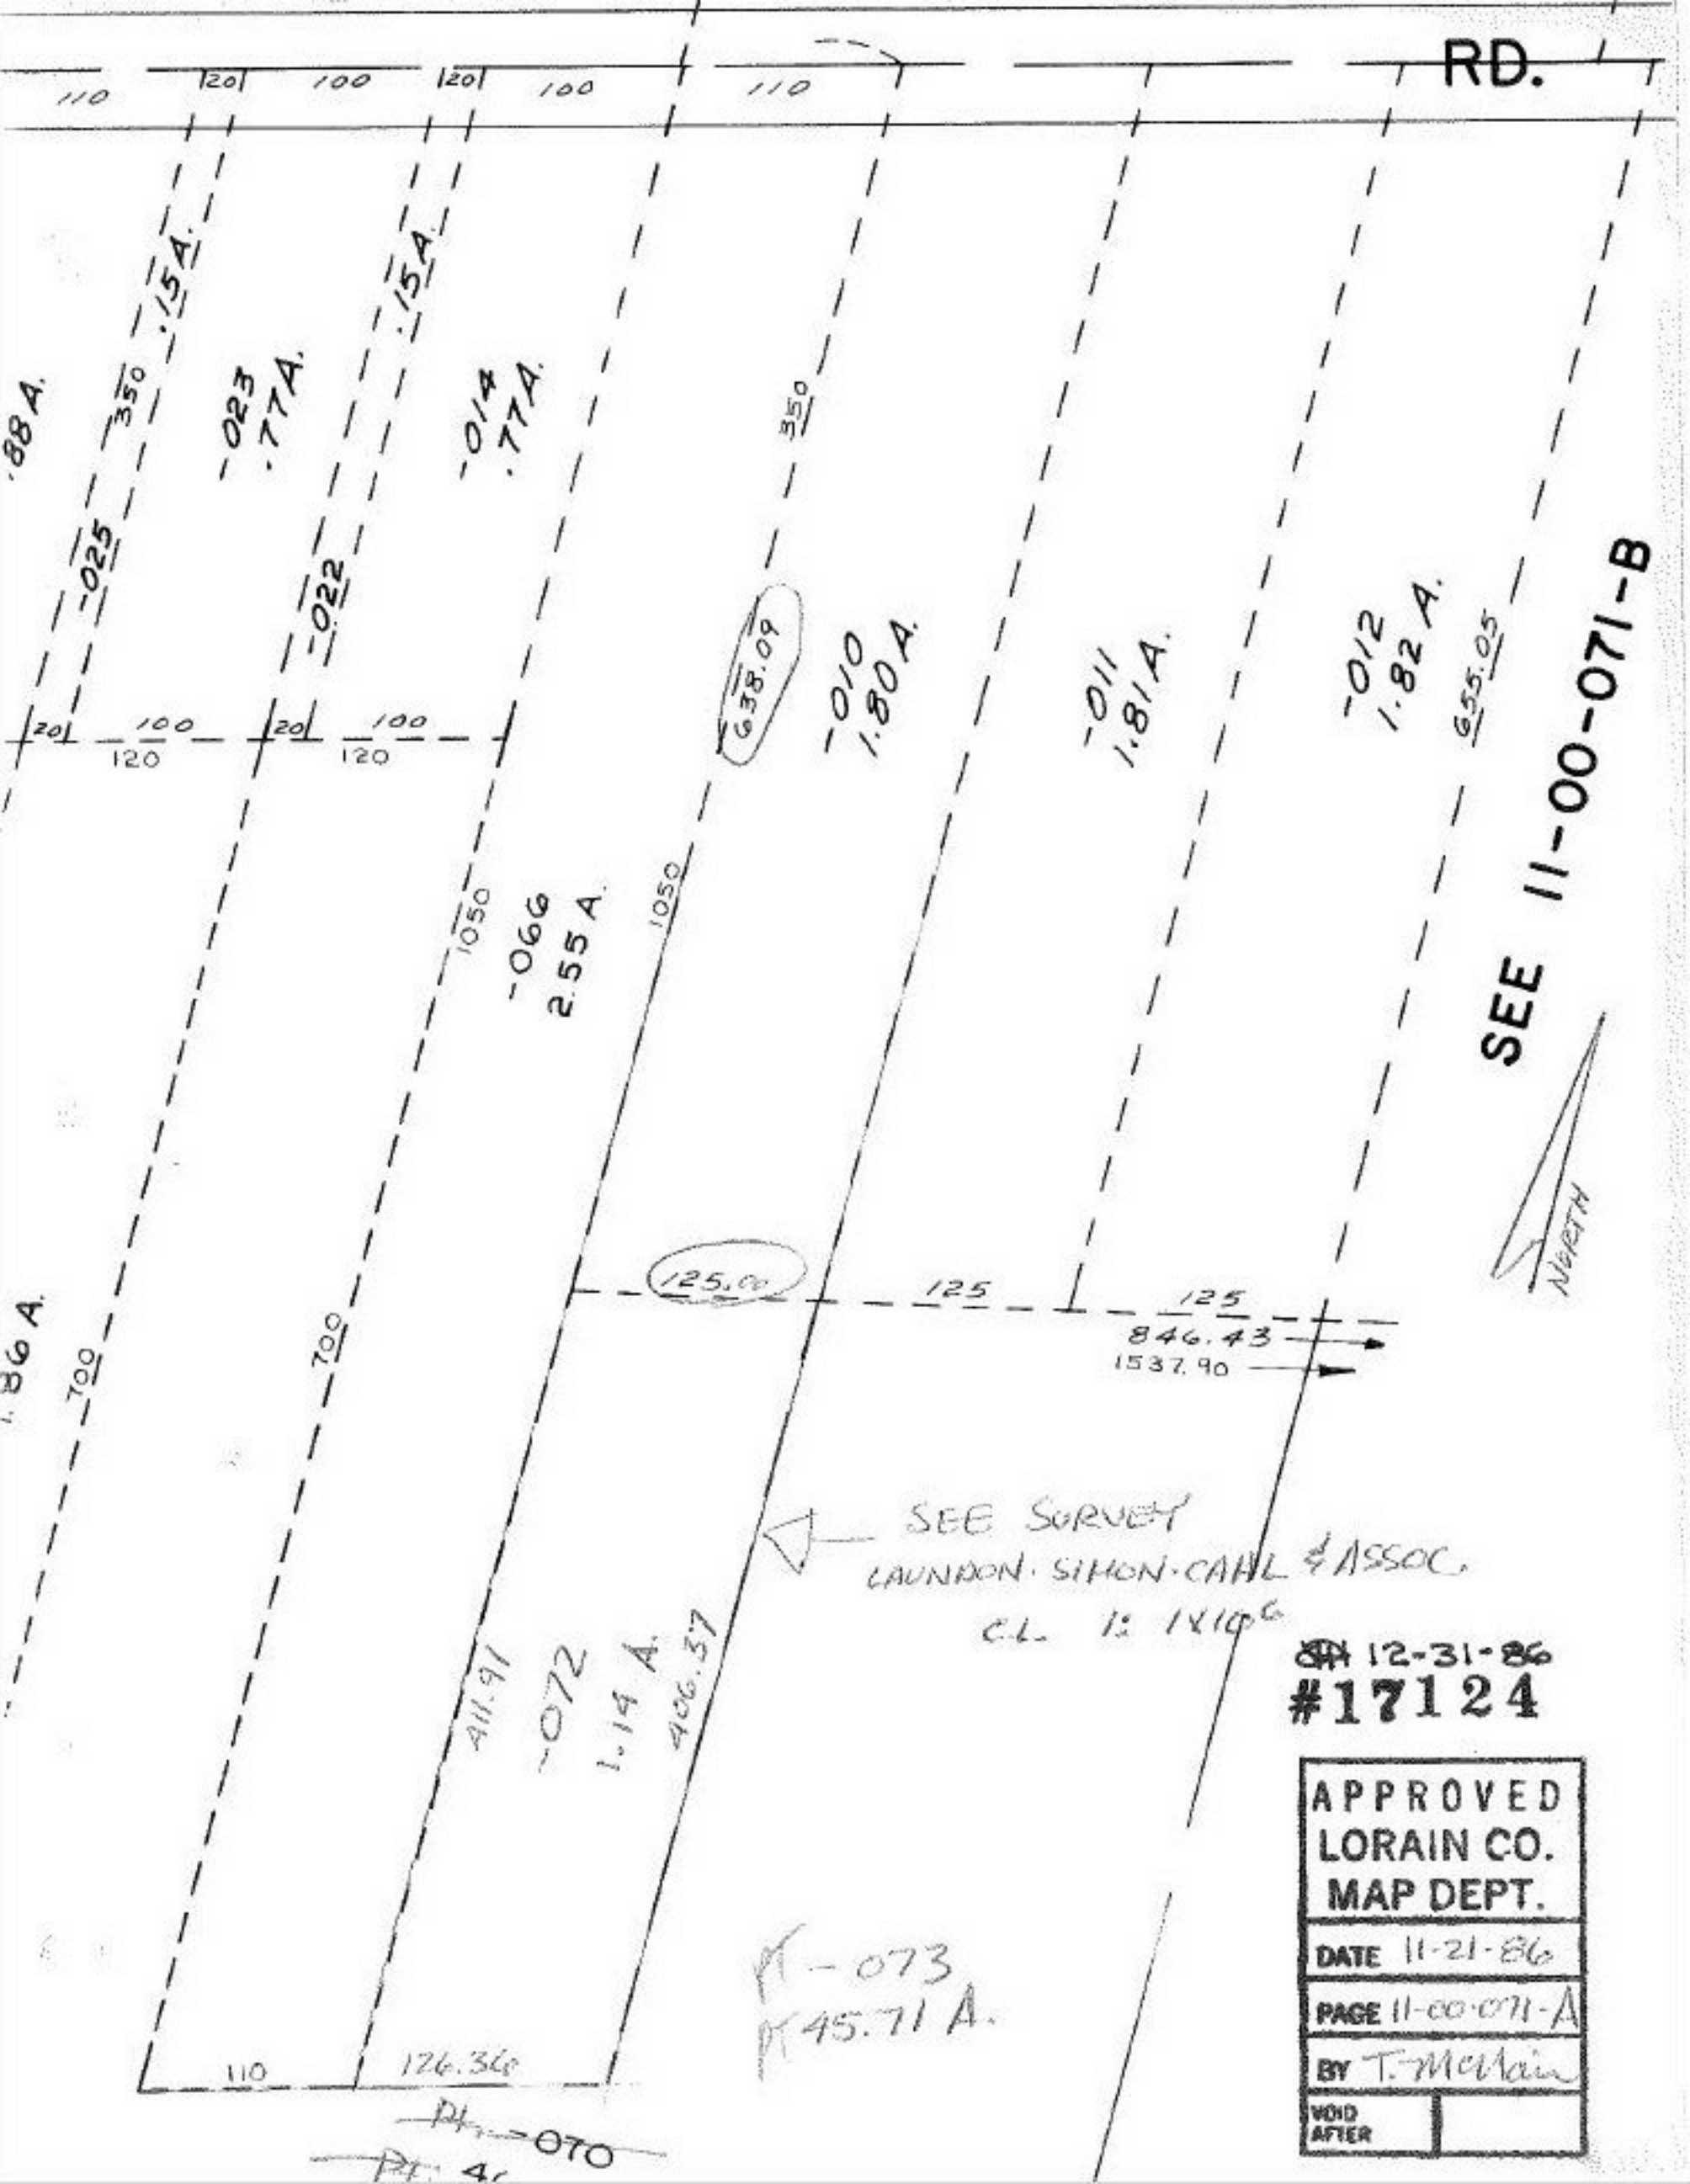

SEE SURVEY  
 LAUNDON SIMON CAHL & ASSOC.  
 CL 1: 1X106

12-31-86  
 #17124

APPROVED LORAIN CO. MAP DEPT.	
DATE 11-21-86	
PAGE 11-00-071-A	
BY T. McVain	
VOID AFTER	

PT - 073  
 PT 45.71 A.

PT - 070  
 PT 41