


1713

6-1-8706

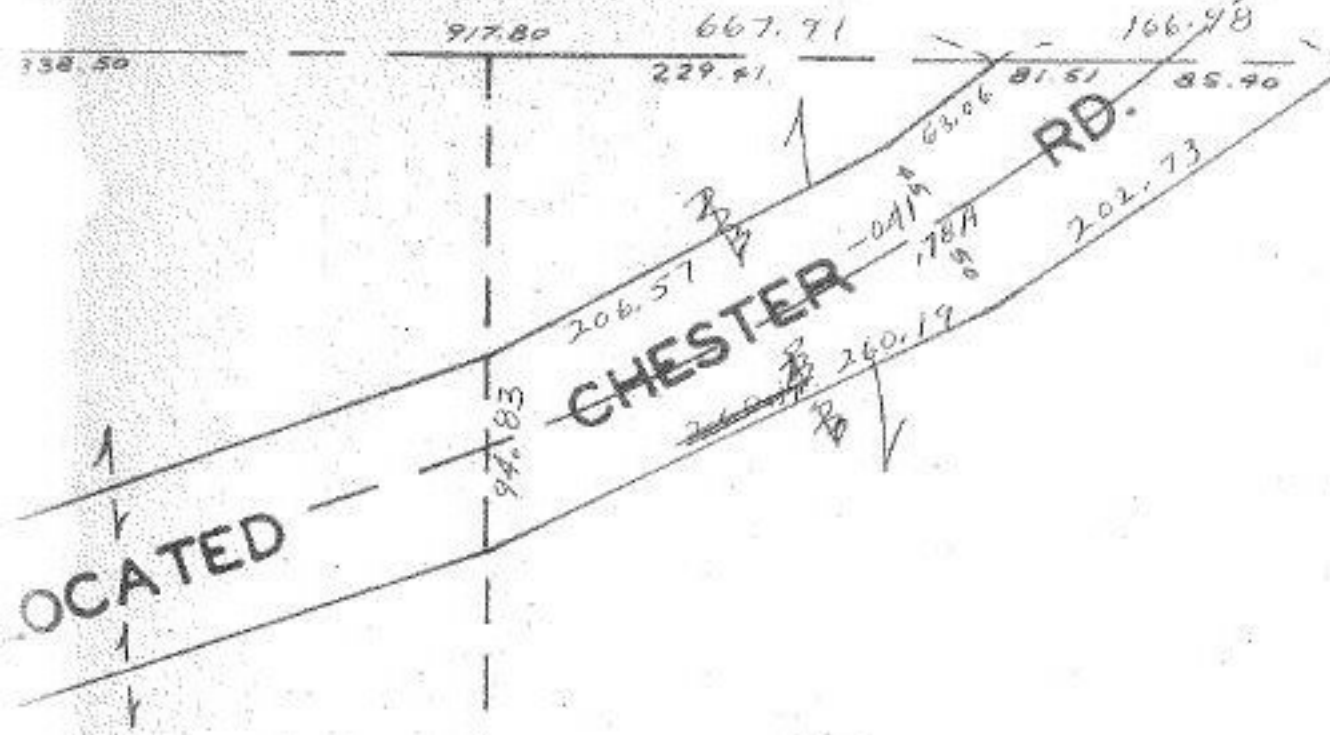

~~APPROVED
LORAIN CO.
MAP DEPT.
DATE
BY~~

7-30-864
#1713
APPROVED
LORAIN CO.
MAP DEPT.
DATE 4-24-68
4-00-027 EA
BY
D. Raymond

[Handwritten signature]

PT-042
PT 36.62

PT 002
PT 37.40A

DONE 7/8/68 H. Kochis