


1903.83 S.E. M.C.

3

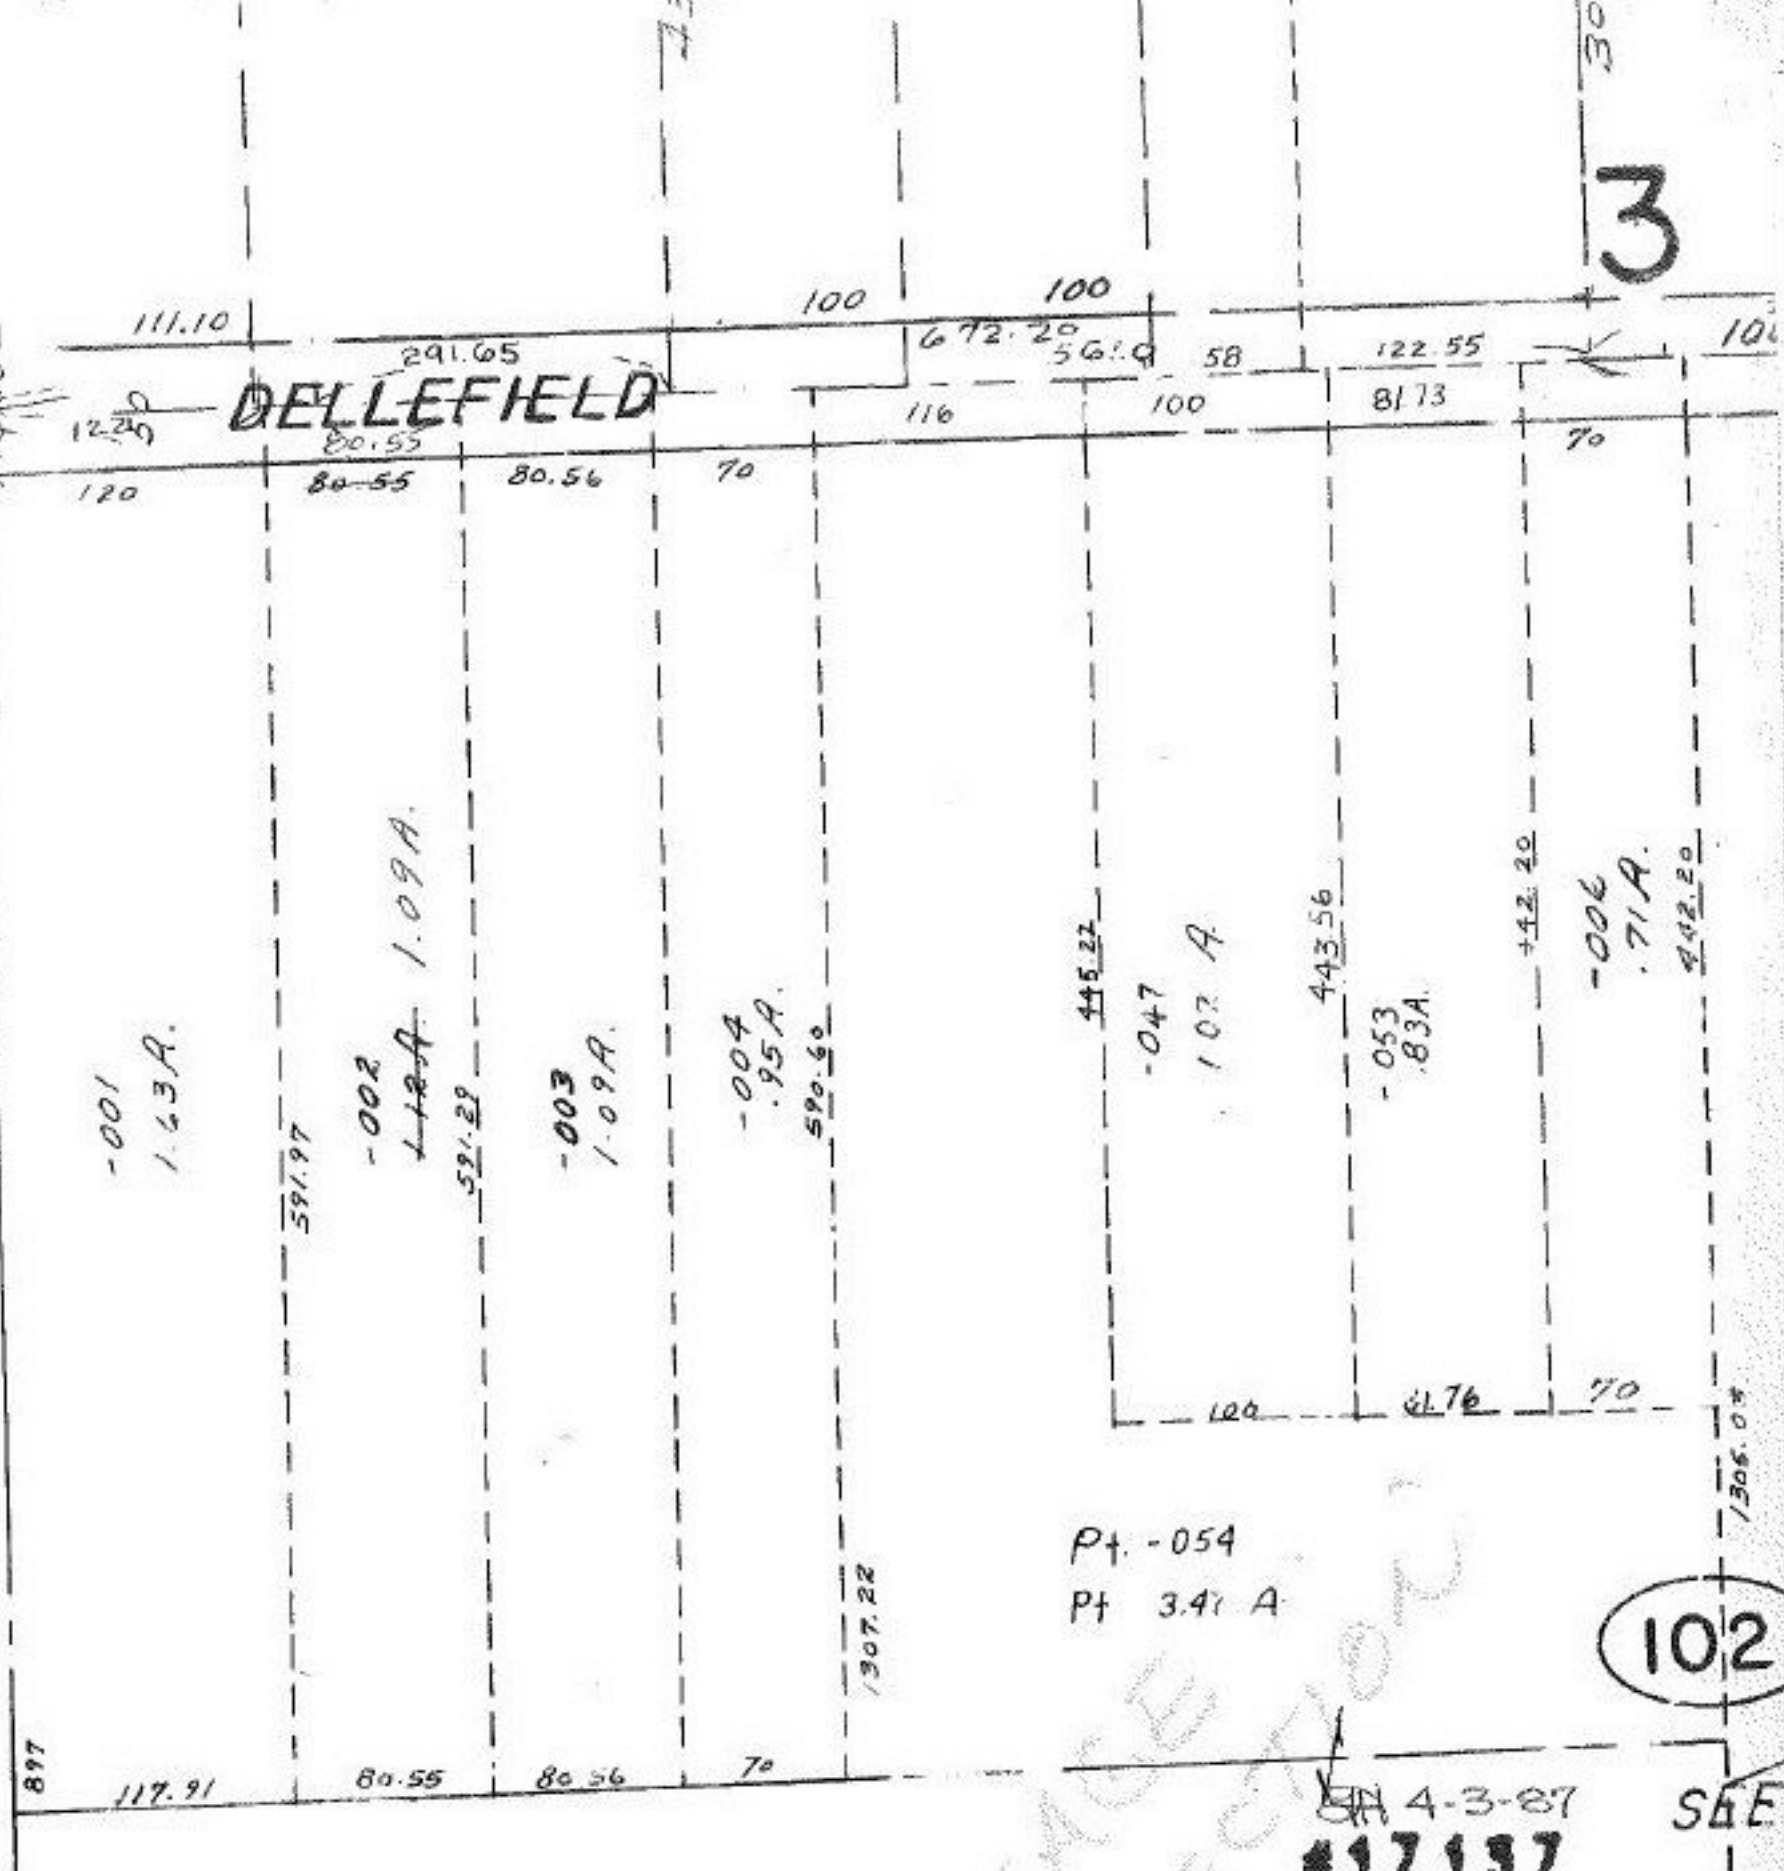

102

4-3-87
#17137

APPROVED
LORAIN CO.
MAP DEPT.

DATE 12-2-86

PAGE 6-21

BY *[Signature]*

WORD AFTER 17137

BRACE TRACT LOT 2 & Niy. PT. LOT 3