


3
AKE

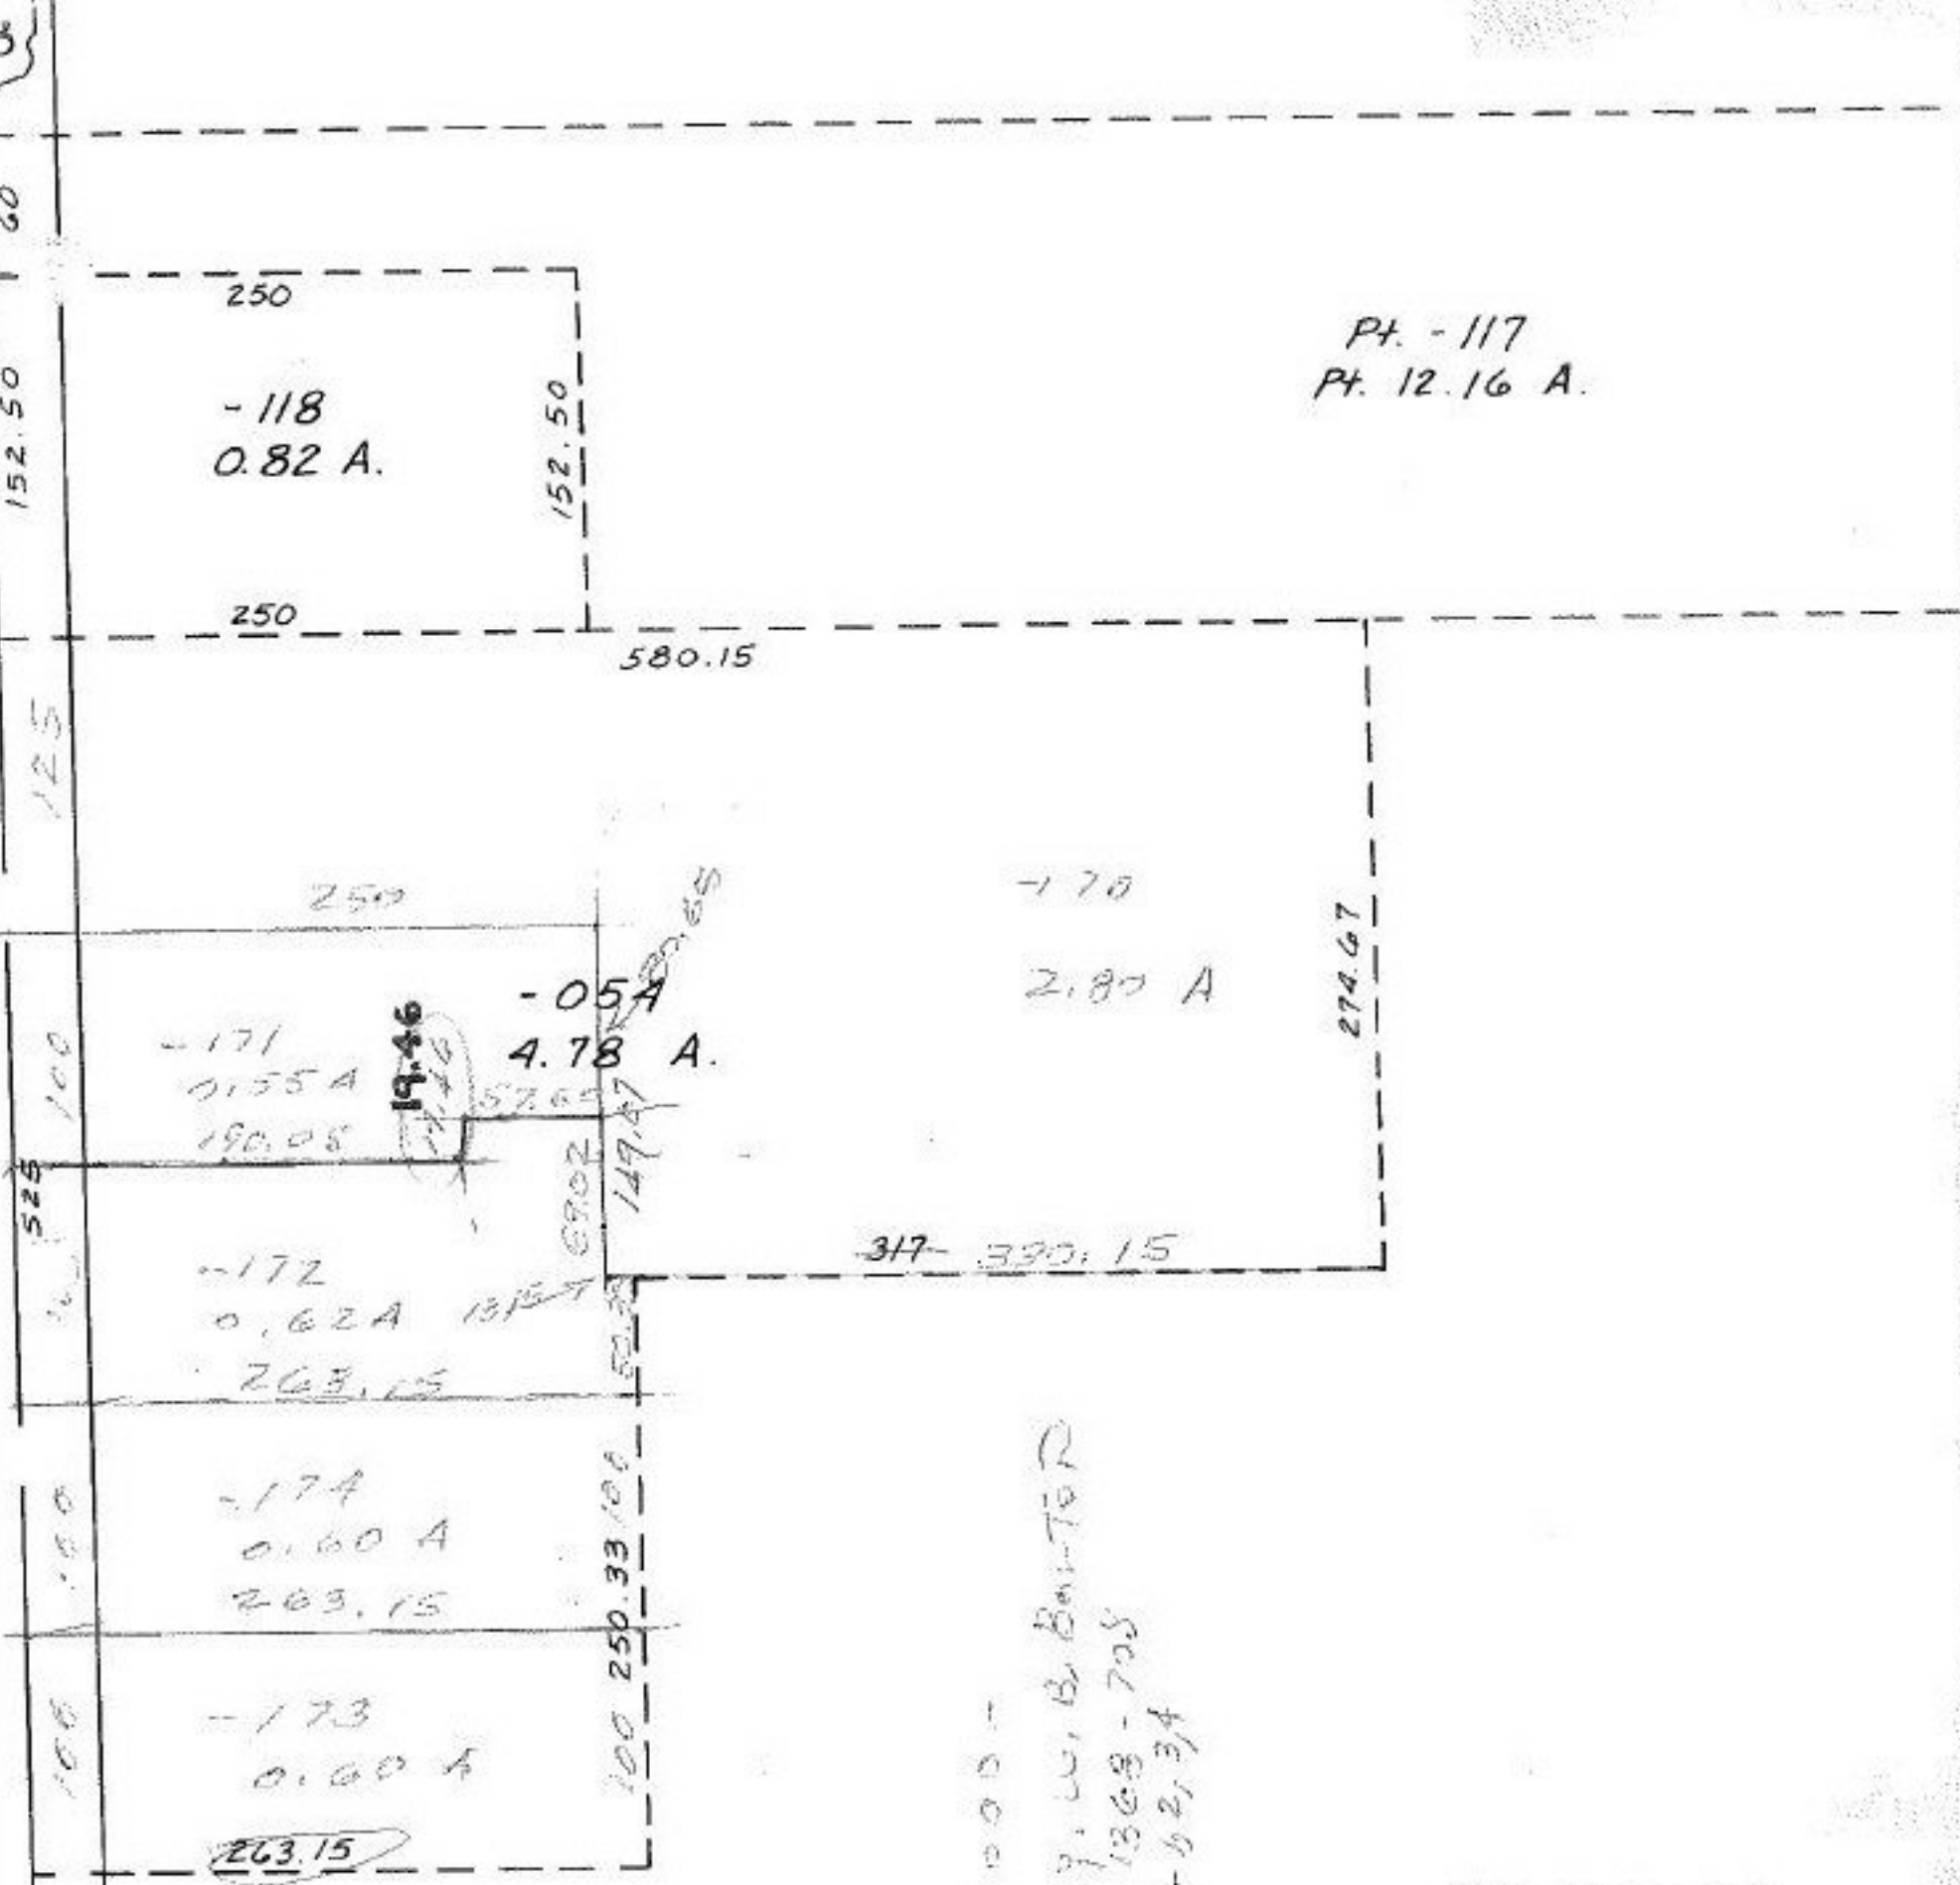

Pt. - 117
Pt. 12.16 A.

04-00-013-000-
Surveyed By: W. B. BOSTON
Prior Decd 1368-708
E-11/NE R-62,34

SN 12-31-86
#17147

| | |
|------------------------|------------|
| APPROVED | |
| LORAIN CO. Pt. - 053 | |
| MAP DEPT. Pt. 70.22 A. | |
| DATE | 2-10-86 |
| PAGE | 00-013-0 |
| BY | E. Francis |
| VOID AFTER | 17147 |