

SEE 10-00-008-D

1666.30
200

10-00-007-101-
SURVEYED BY JOHN POZYWAK


P-1 C=1:1111 500000

- 2 C=1:33401 INF
- 3 C=1:4444 250000
- 4 C=1:1111 333333
- 5 C=1:333333

PT. 012

PT. 12,21 A.

2641.98
2640.75

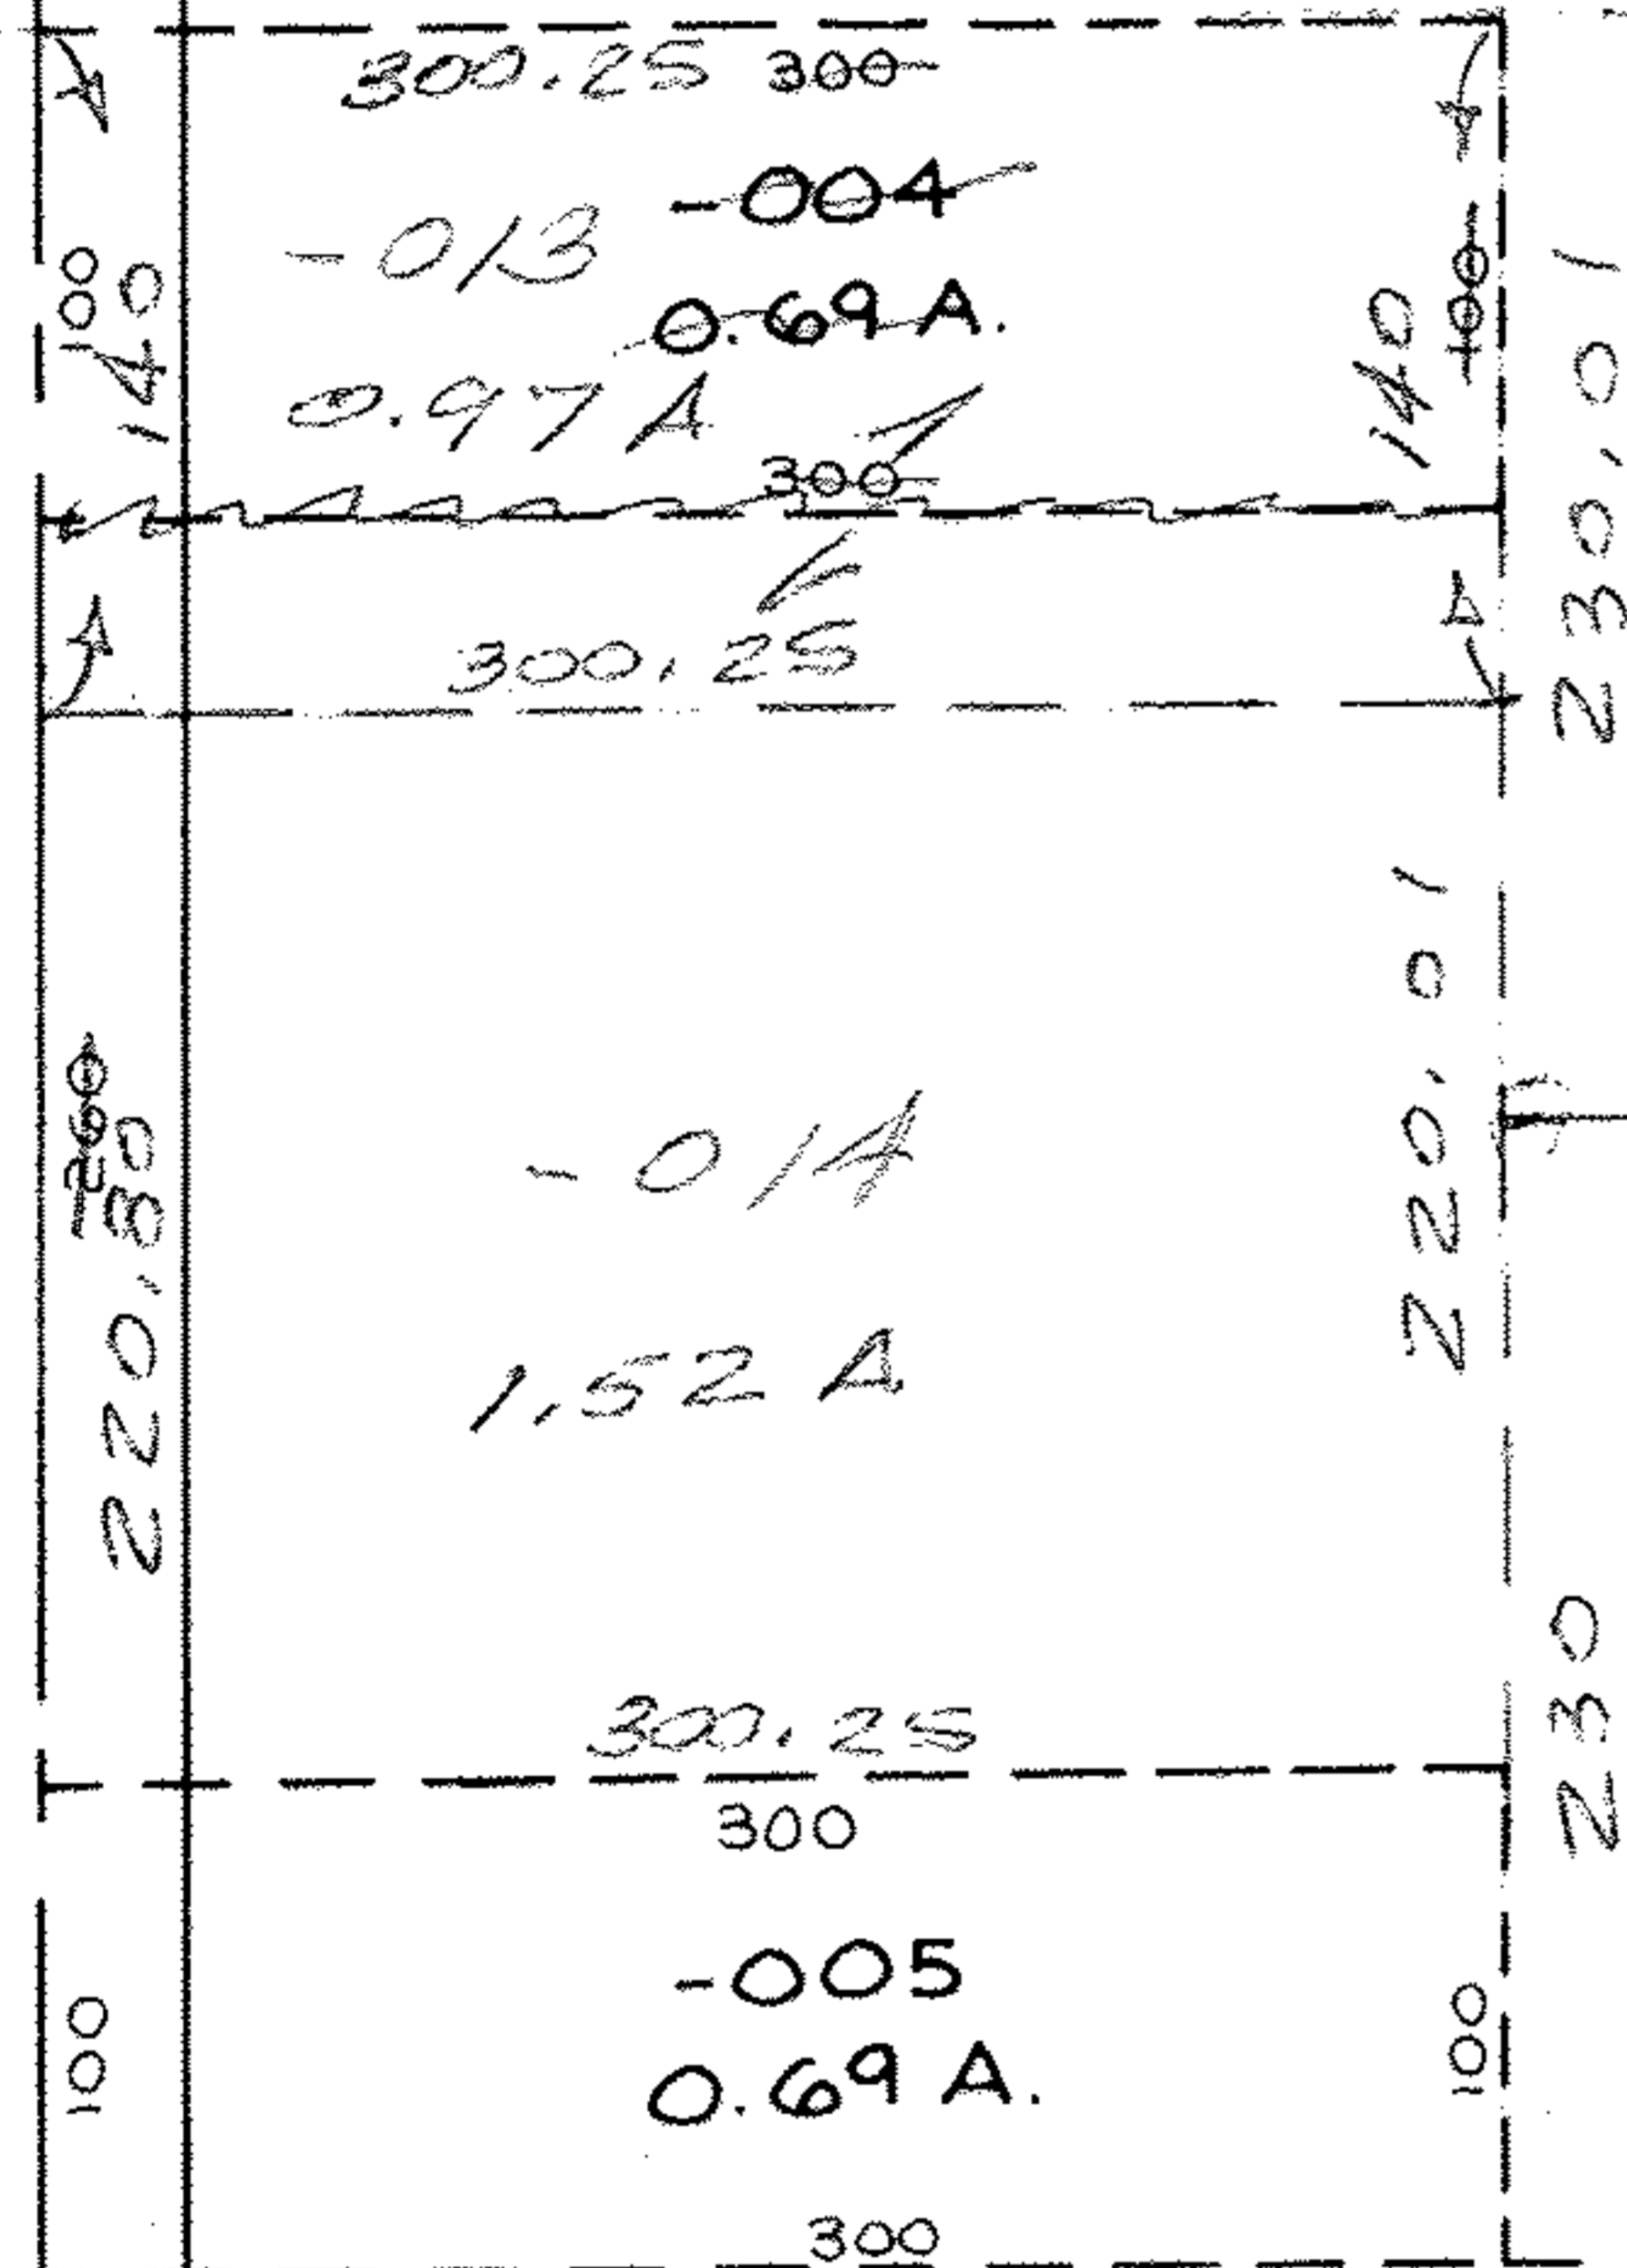

2340.93

PT. ~~015~~ - 015
 PT. ~~12,36 A~~ 12,36 A.
 PT. ~~003~~
 PT. ~~38.62 A~~
~~38.75~~

AC. CORR. PER SURVEY
BY J. POZYWAK Reg. Surveyor

2341.40

PT. - 016
 PT. 12,36 A

7-15-87
#17150

2341.90
2643.96

APPROVED	
LORAIN CO.	
MAP DEPT.	
DATE 12-11-86	
PROJECT 10-00-007-A	
BY C. FRANCIS	
VOID	17150
AFTER	

101

SEE 10-00-007-B