
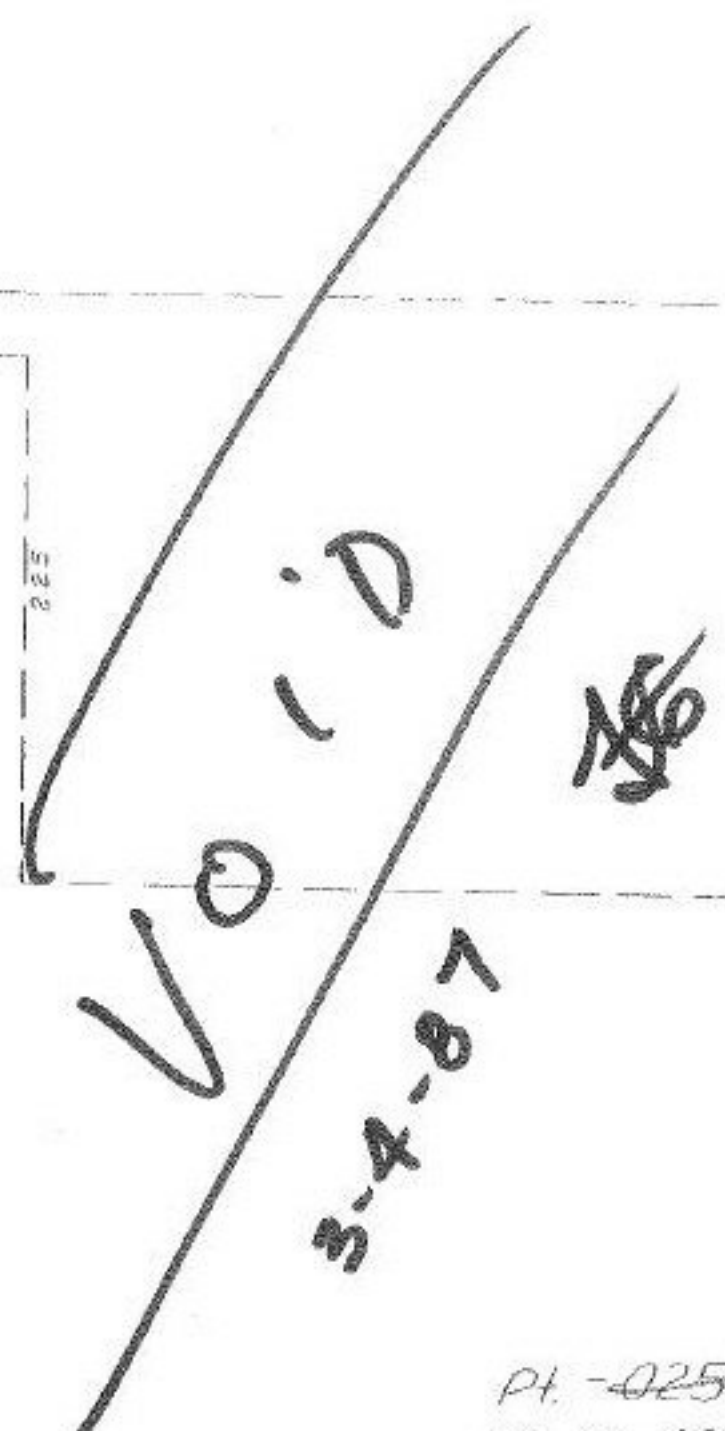


PT. 001  
PT. 40.00 A

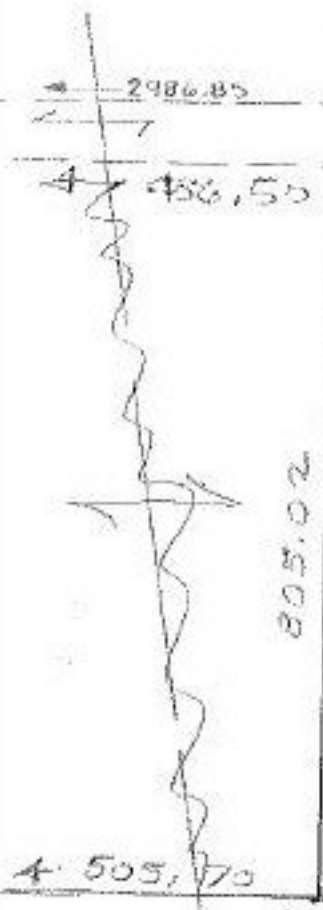

PT. - 002  
PT. 8.56 A.

1143.54

PT. - 025 - 051  
PT. 16.08 A. 12.73 Ac.

~~7-29-87~~  
# 17155

APPROVED  
LORAIN CO.  
MAP DEPT.  
DATE 12-15-86  
DISE 15-00-072-B  
BY C. FRANCIS

2410.80  
100

EQUESTRIAN

ACRES 17155