


03-00-008-000-
Prior Deed 731-301
SKETCH BY MARTINI
Reg. Surveyor
C=1:1NF

- 011

~~28.92 A~~
25.25

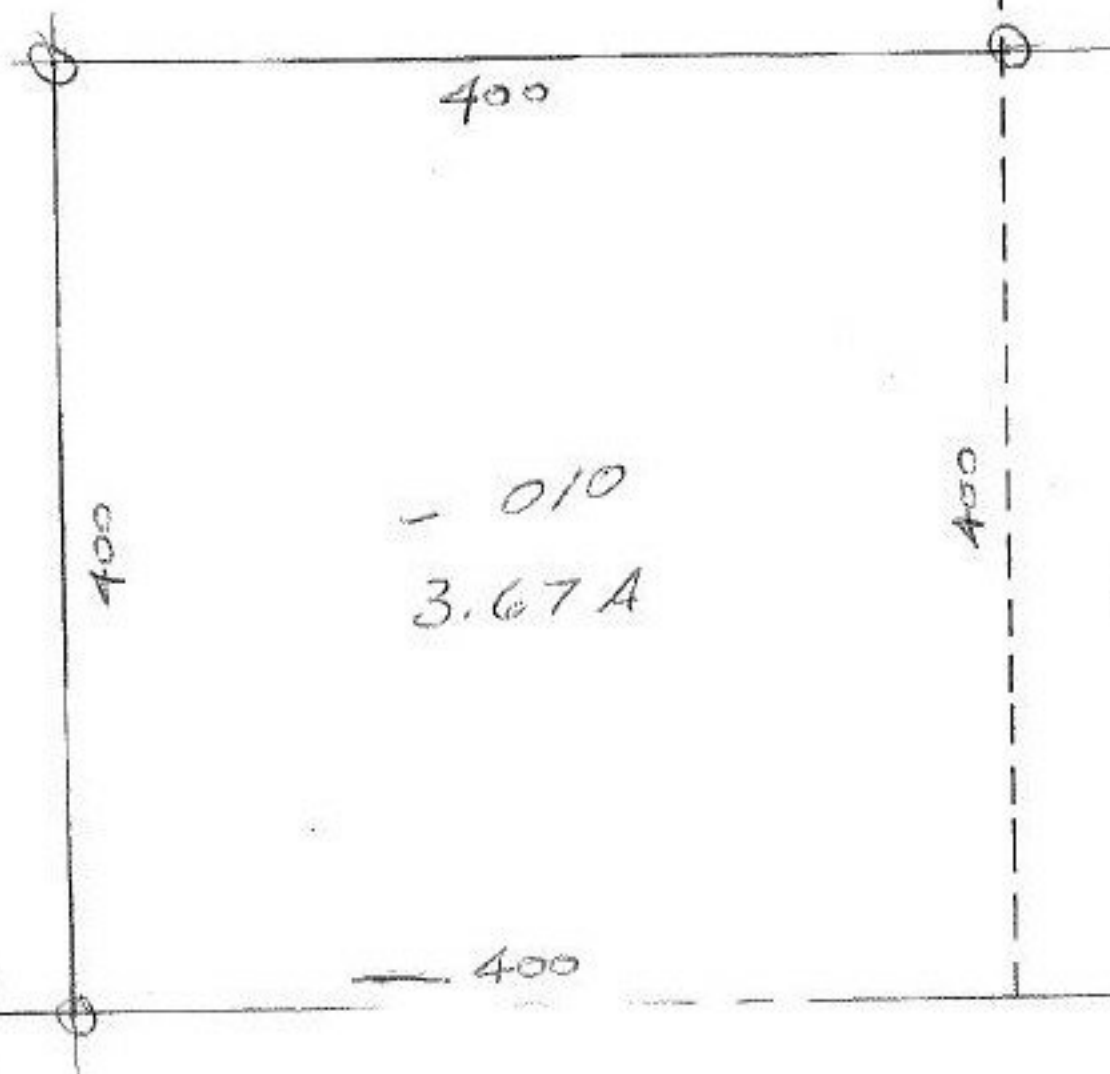

~~SN~~ 5-1-87
#17173

APPLIED
LORR CO.
MAP DEPT.

DATE 12-23-86

PAGE 3-00-008B

BY C. FRANCIS

VOID
AFTER 17173