

1720

SEE 2-02-025-A




(Handwritten signature/initials)

1720

APPROVED
LORAIN CO.
MAP DEPT.
DATE 4-30-68
2-02-016-A
BY <i>(Signature)</i>

S. 98-11-L

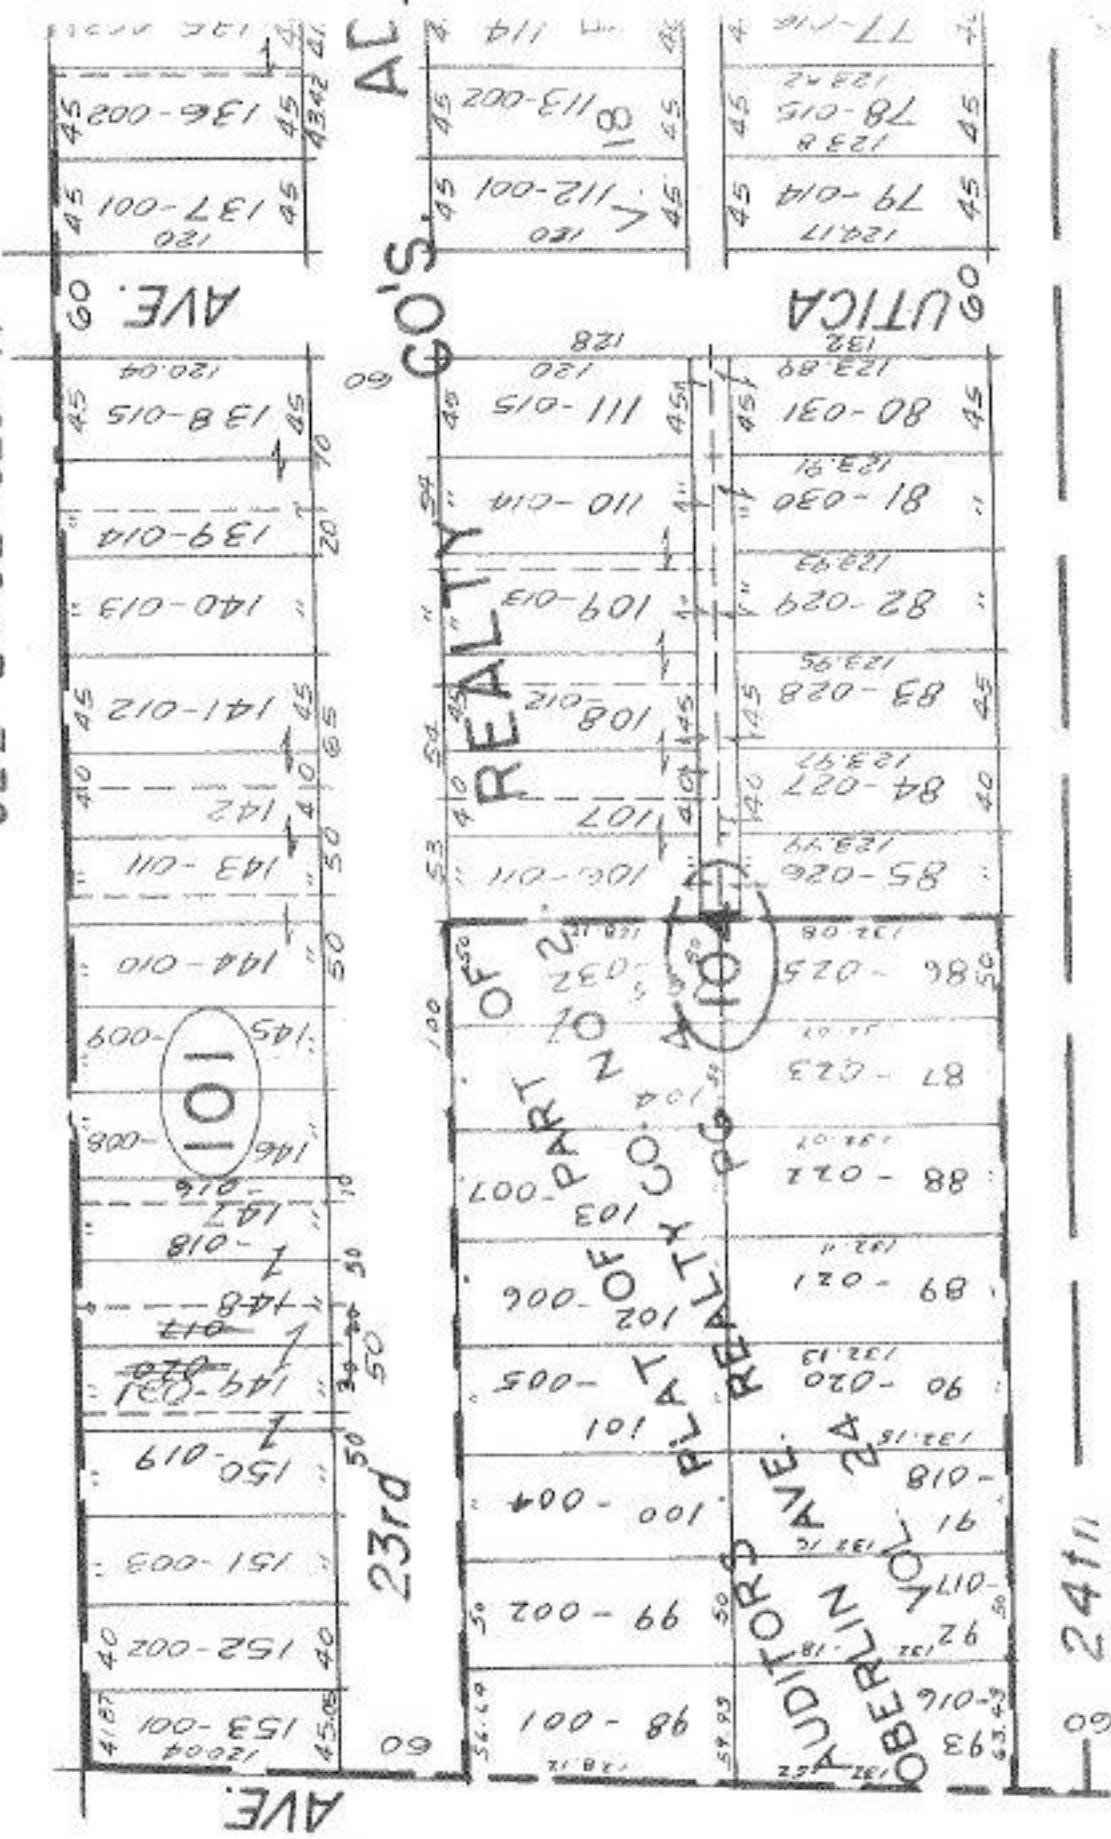

2411

Done 7-6-68 LWAH