


06-24-001-000

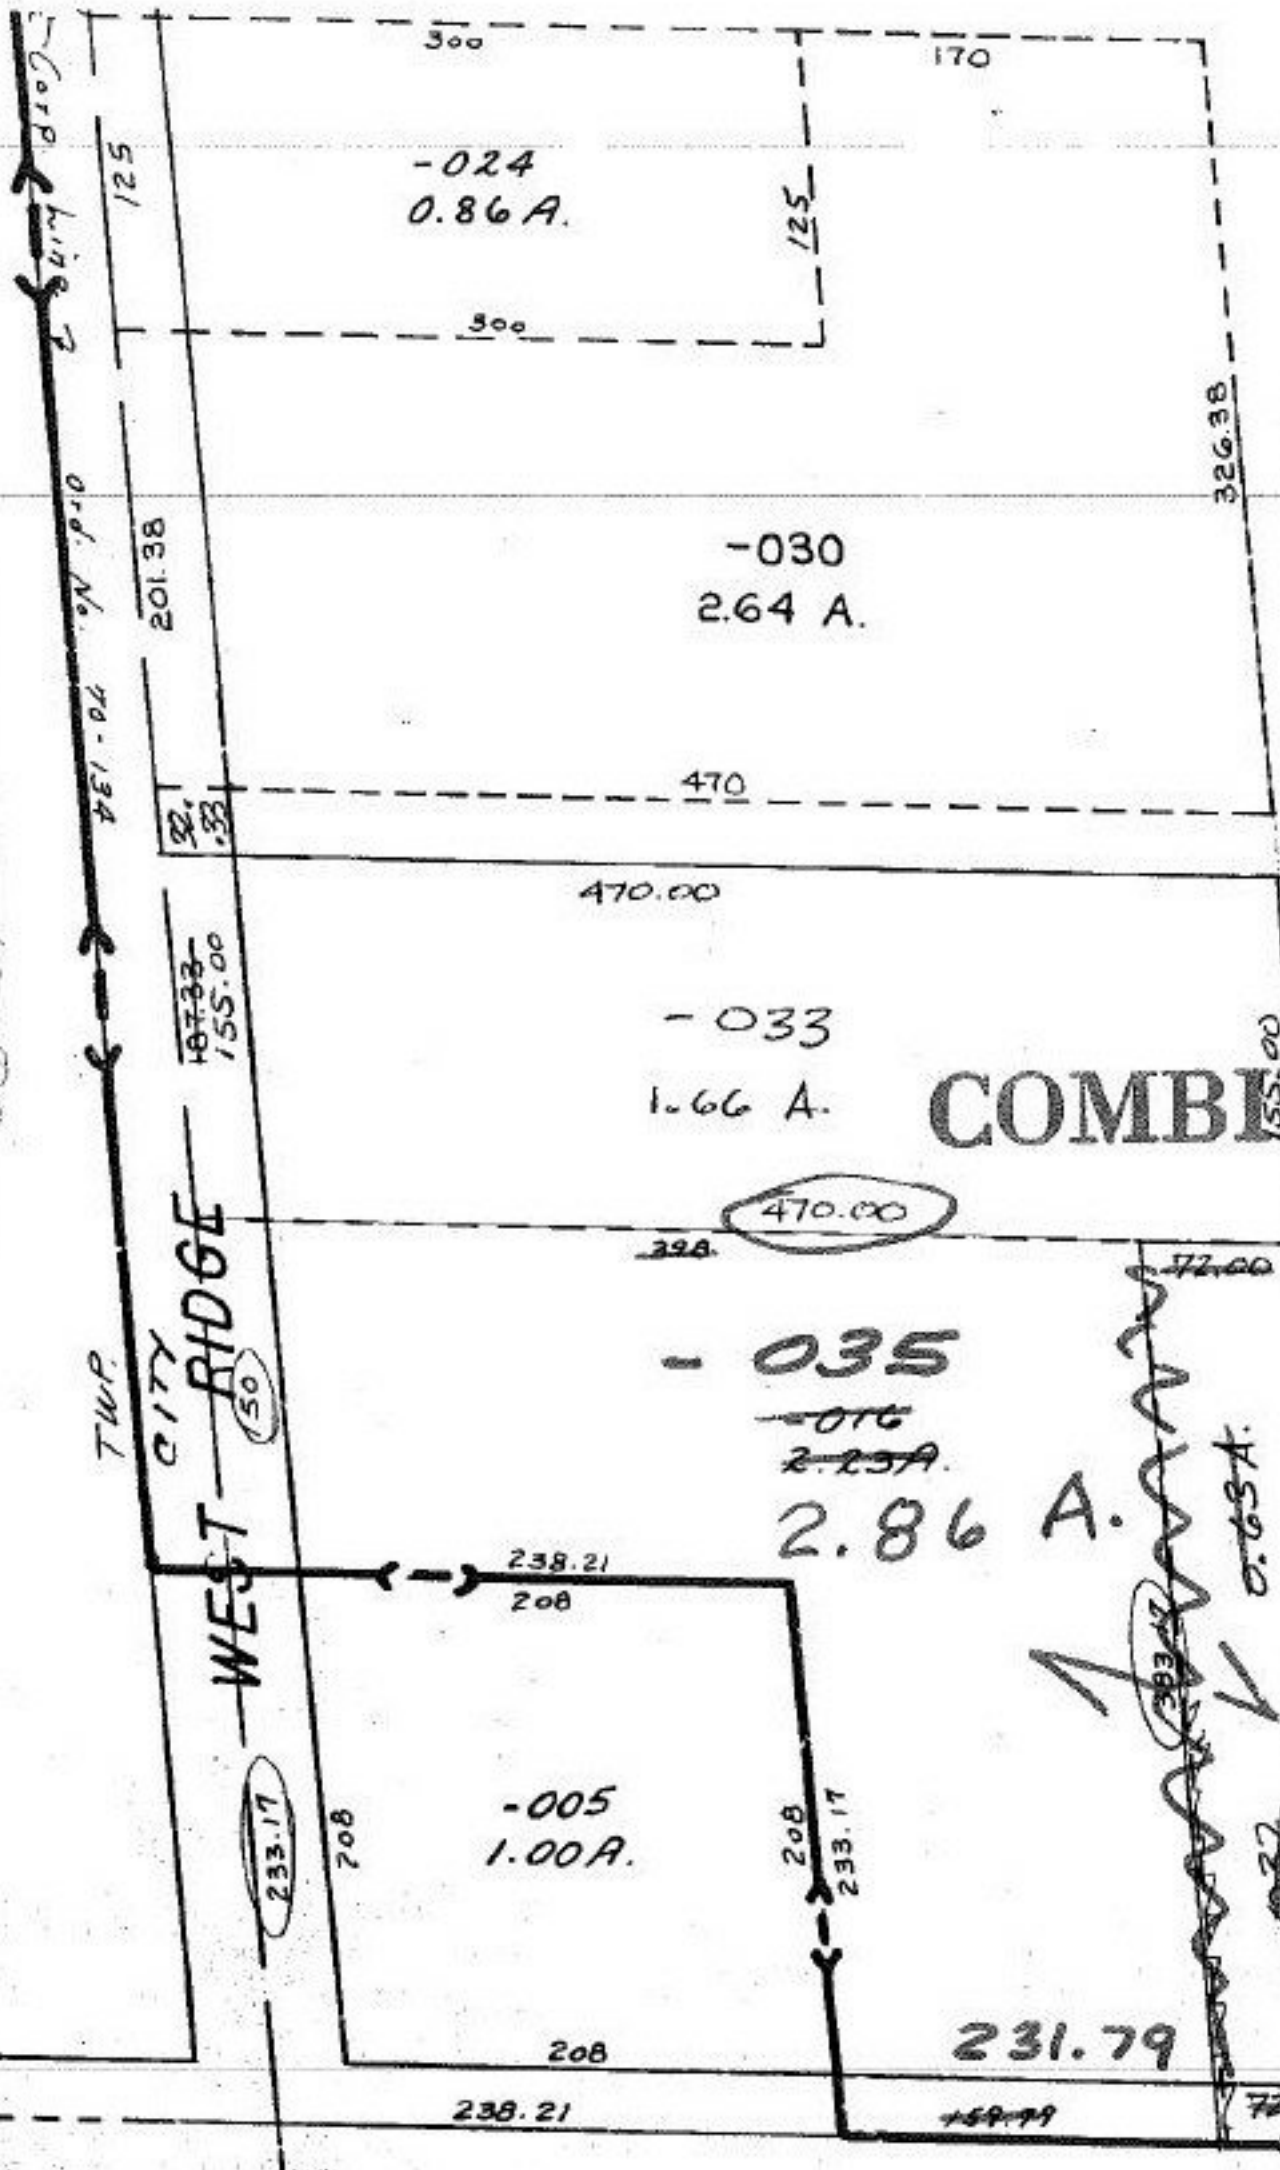

"SURVEY" MAP BY
KLEINODER-SCHMIDT
CL. 1: INF
NOTE - NO MONUMENTA-
TION SHOWN ON
EITHER PARCEL
BEING SPLIT.
SURVEY QUESTIONABLE

~~031~~
~~15.56 A.~~

COMBINATION

13.27 A
4-7-87
#17203

APPROVED
LORAIN CO.
MAP DEPT.

DATE 1-6-87

PAGE 6-12B

J. FRANCIS

VOID AFTER 17203

~~#17162~~

~~APPROVED
LORAIN CO.
MAP DEPT.~~

~~DATE 12-17-86~~

~~PAGE 6-12B~~

~~BY T. McNeil~~

~~VOID AFTER~~

502.64
72.00
430 64