

17 22

EE 11-00-089-B

Lot Line



#1722
APPROVED
LORAIN CO.
MAP DEPT.
 DATE 4-30-68
 11-00-089-B
 BY *D. Maynard*


D.S.
7-25-76

11-029
11-63A
-005
-005

217
 350
 -628
 .57A
 215.80
 123.42
 160

RD.
323.42
400

~~019~~
~~899A~~

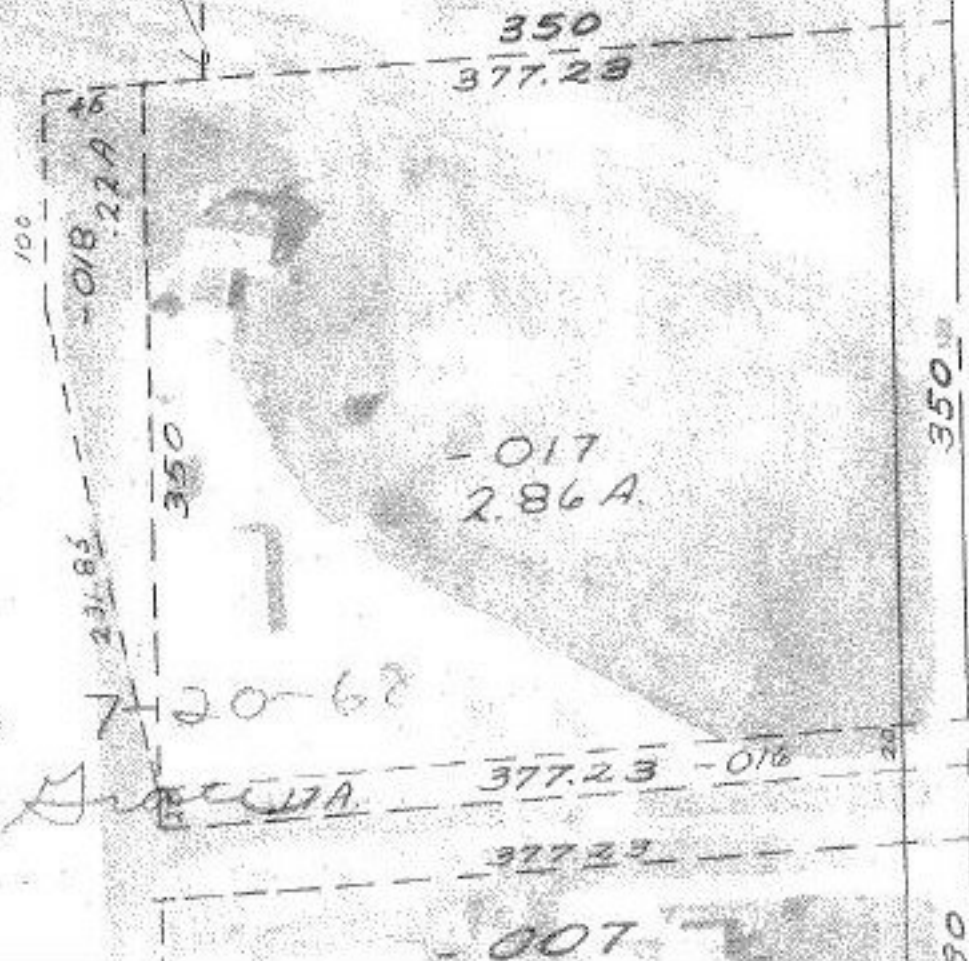

Done
7-20-68
John [unclear]

1722