


DENVER

COMBINATION

(39th ST.)

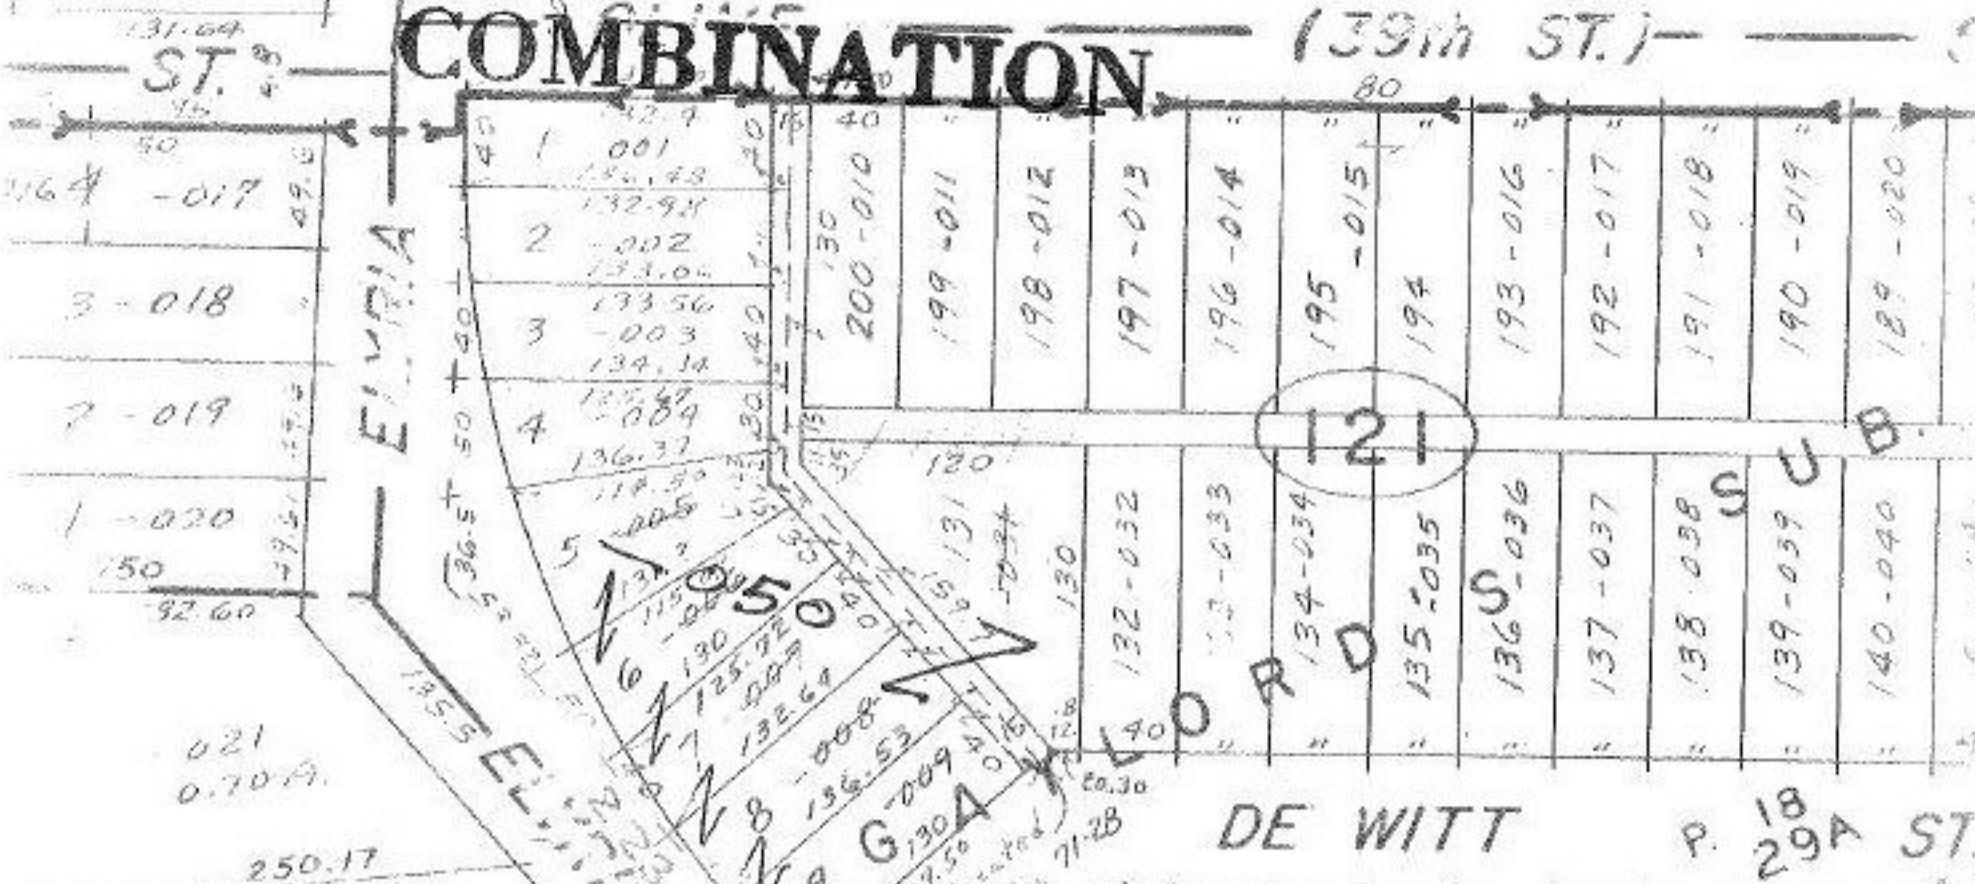

ELMIRA

DE WITT

29A ST.



#17240

APPROVED
LORAIN CO.
MAP DEPT.
DATE 1-23-87
PAGE 3-00-103-A
BY C. FRANCIS
VOID AFTER 17240

AVENUE

HARR