

NORTH LINE PARCEL
TOP OF
469.26

1837.44

-016
17.03A
17.28A



AC. CORR.
ONLY
SURVEYED BY: K.S.A.
C=1:22727.

1843.74

CORP

AMHERST

SOUTH 528.62

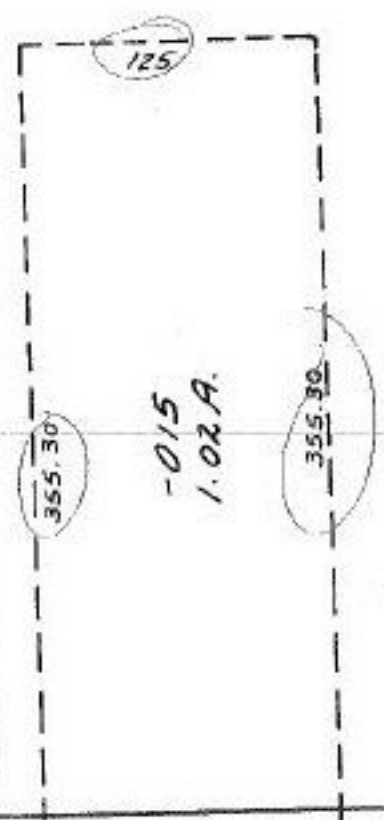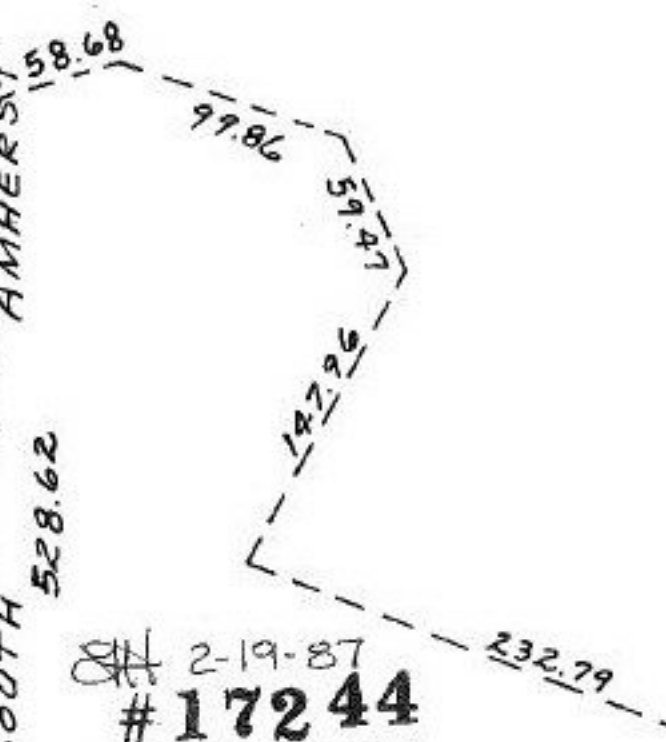

2-19-87
#17244

APPROVED LORAIN CO. MAP DEPT. -013	
DATE 1-23-87 373 A.	
PAGE 900-013-A	
BY Francis	
VOID AFTER	17244